


**LEGEND**

- EXPOSED WOOD BEAM ABOVE
- WOOD BEAM ABOVE
- DR. HEADER TYP. DROPPED DOOR HEADER
- COLUMN
- DOORWAY ARCH, BRICK
- BRICK ARCH

Appendix B  
 Conceptual drawings for Fletcher Free  
 Library HVAC Upgrades Project  
 January 30, 2015

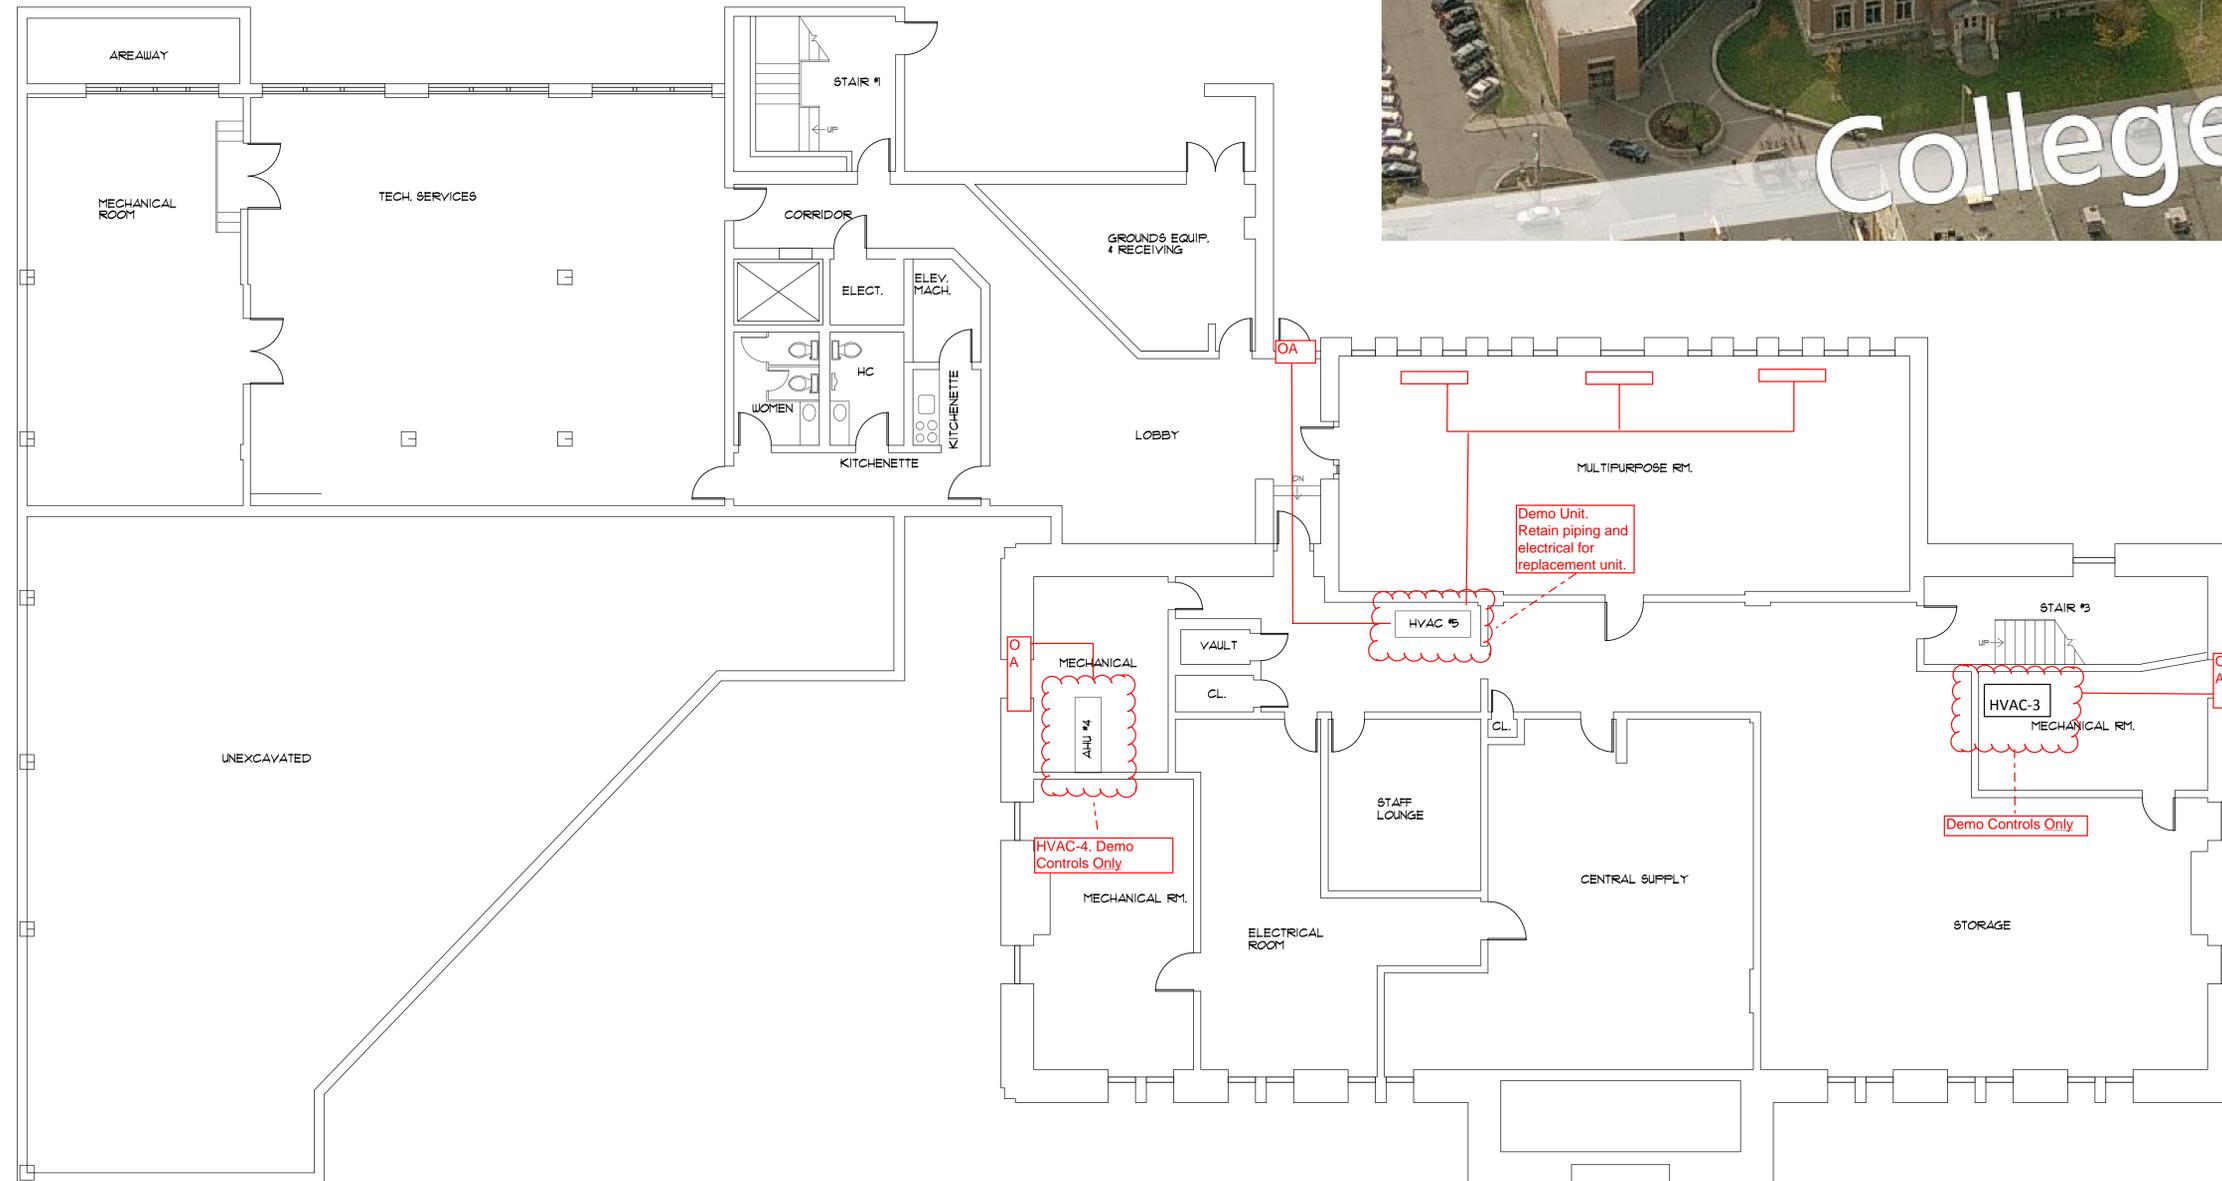

**LOWER LEVEL PLAN**  
 SCALE: 1/8" = 1'-0"  
**Mechanical Demolition Plan**

Cx Associates  
 January 30, 2015

City of Burlington FFL HVAC Upgrades  
 Drawing Markups

**NOTE:** Drawings reflect conceptual design intent only. Bidders must field verify any information critical to accurate bidding.

- NOTES:**
1. THIS PLAN IS BASED ON ORIGINAL DRAWINGS PREPARED BY ANDERSON NOTTER FINEGOLD, ARCHITECTS DATED 7-11-79. VARIOUS RENOVATION PROJECT PLANS PROVIDED BY FLETCHER FREE LIBRARY VAULT.
  2. THE BUILDING WAS FIELD CHECKED BY BUXTON DRAFTING SERVICES IN JUNE, 2012. THE PLANS WERE THEN MODIFIED TO REFLECT FIELD MEASUREMENTS. THE ENTIRE BUILDING WAS NOT MEASURED. FOR FUTURE RENOVATIONS, ACTUAL DIMENSIONS MUST BE FIELD VERIFIED.
  3. NO DEMOLITION WAS PERFORMED TO DETERMINE ALL WALL THICKNESSES - WALL THICKNESS MAY VARY FROM LOCATION TO LOCATION. WALL LOCATIONS MUST BE FIELD VERIFIED WHEN NEW RENOVATIONS EMERGE.

USER NOTE: ATTENTION WAS MADE IN PREPARING THIS PLAN SET TO AVOID CONFLICTS WITH EXISTING RECORDS. HOWEVER, THE CONTRACTOR MUST VERIFY ALL INFORMATION DURING ANY CONSTRUCTION PHASE. HUMAN ERROR, THE CONTRACTOR MUST VERIFY ALL INFORMATION DURING ANY CONSTRUCTION PHASE.

**CITY OF BURLINGTON  
 DEPARTMENT OF PARKS & RECREATION  
 BURLINGTON, VERMONT**

(802) 658-0293

**FLETCHER FREE LIBRARY  
 BURLINGTON, VERMONT**


**LOWER LEVEL PLAN**

DATE	JUNE 2012
SCALE	1/8" = 1'-0"
DRAWN	LRB
CHECKED	BDS

A-1

**LEGEND**

- EXPOSED WOOD BEAM ABOVE
- WOOD BEAM ABOVE
- DR. HEADER TYP. DROPPED DOOR HEADER
- COLUMN
- DOORWAY ARCH, BRICK
- BRICK ARCH

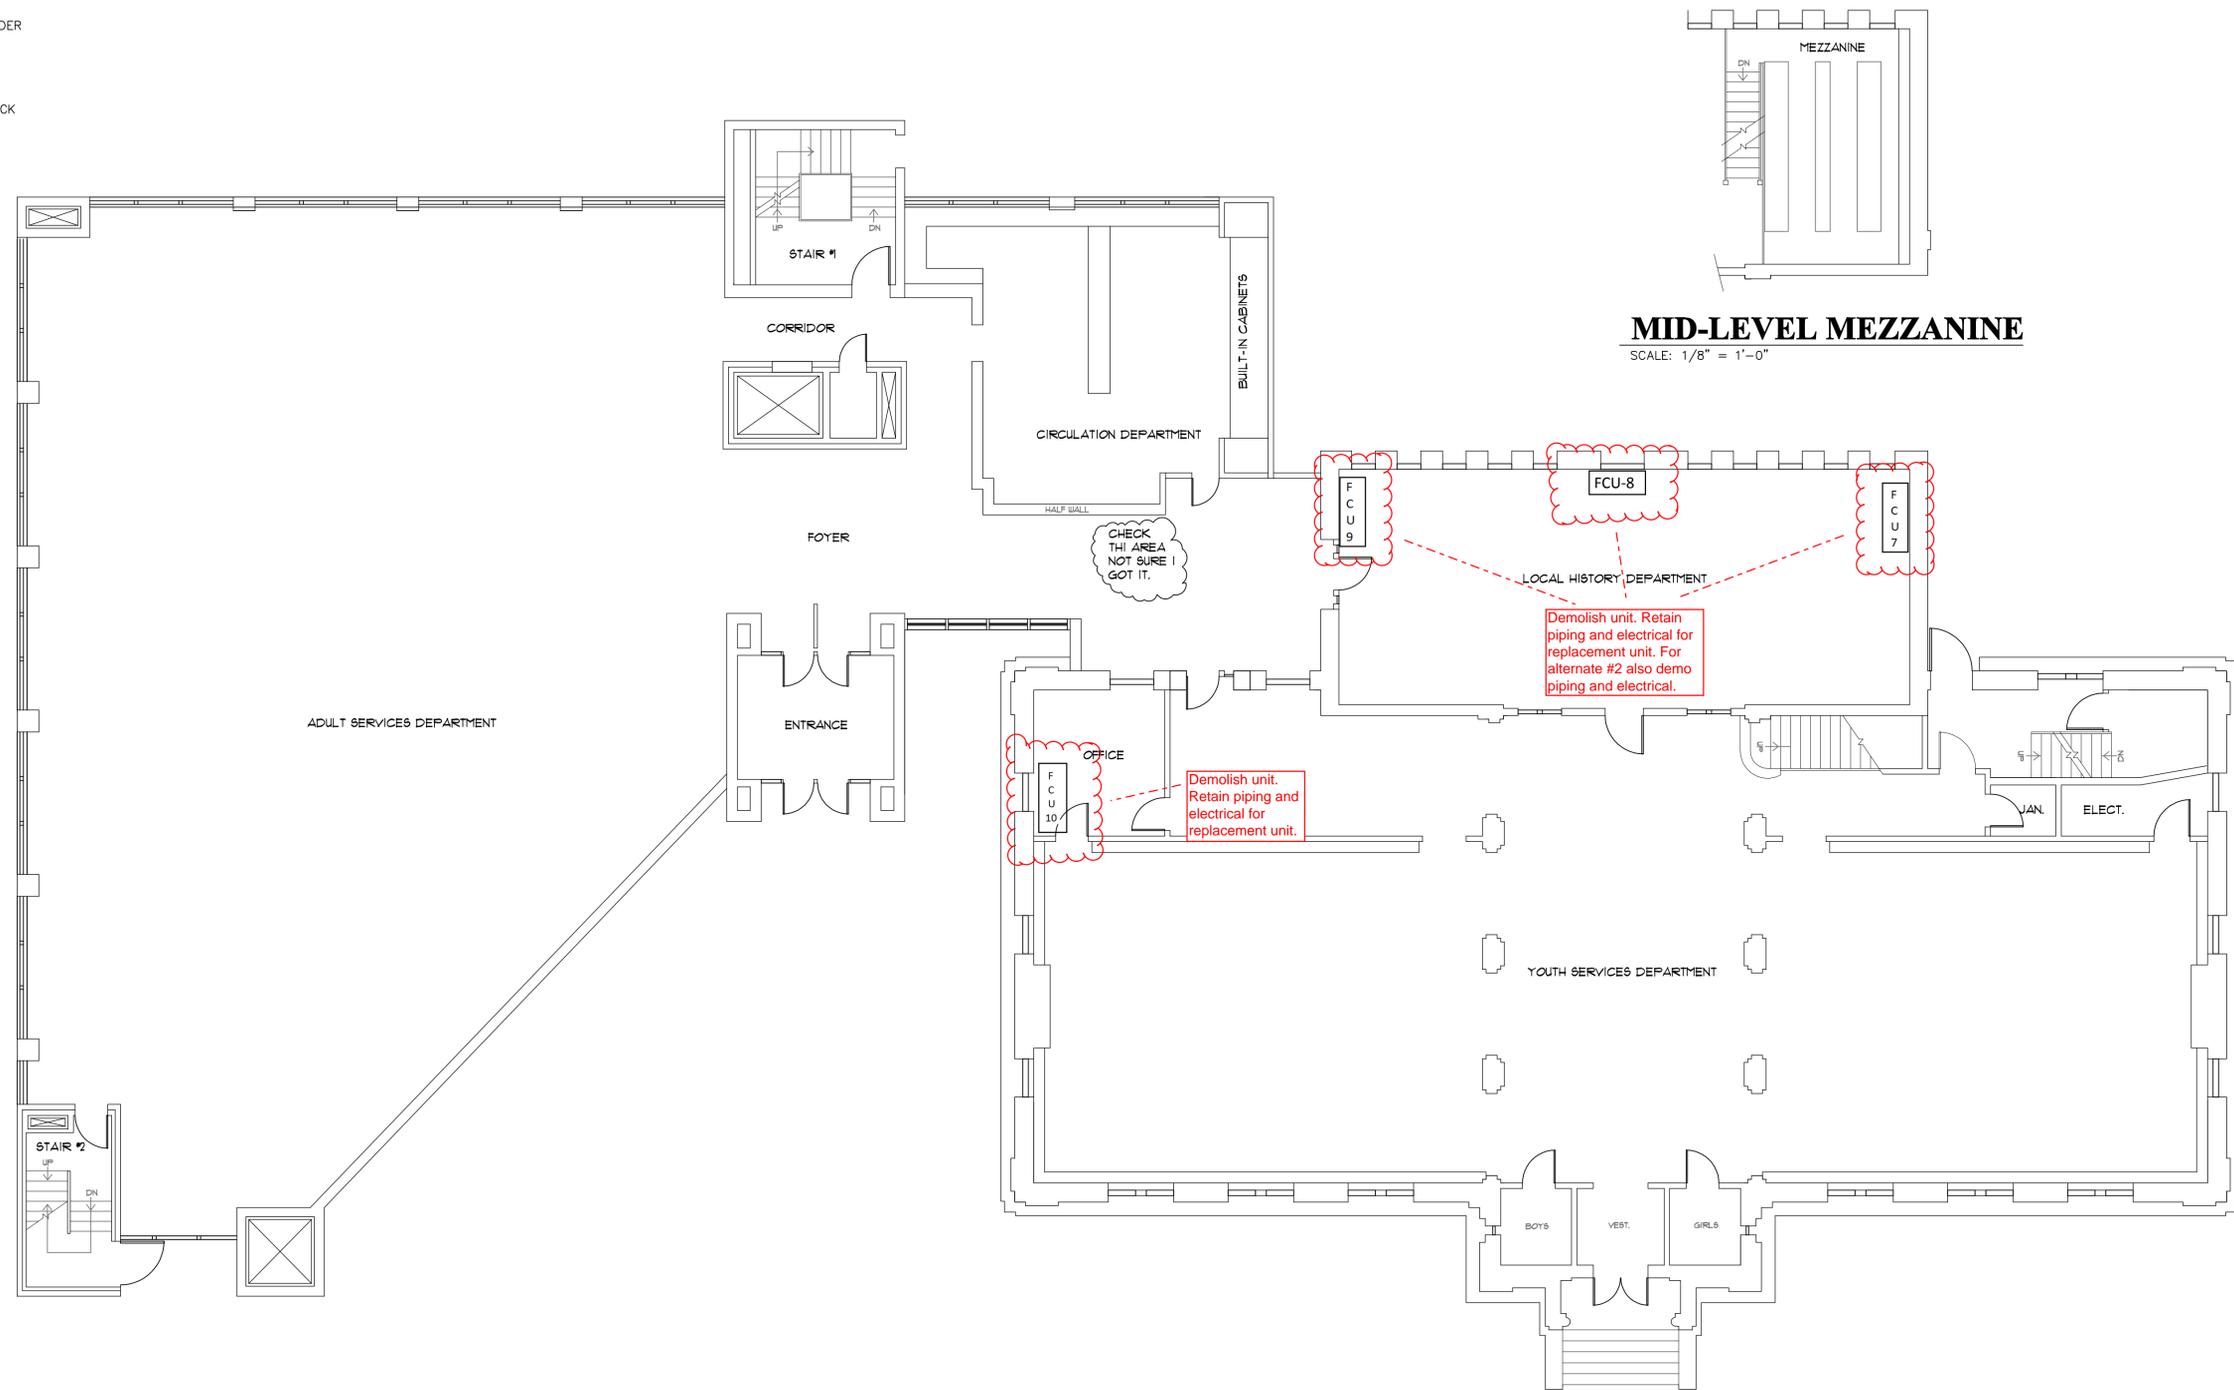

**MID-LEVEL MEZZANINE**  
SCALE: 1/8" = 1'-0"

**MAIN LEVEL PLAN**  
SCALE: 1/8" = 1'-0"

**Mechanical Demolition Plan**

Cx Associates  
January 30, 2015

City of Burlington FFL HVAC Upgrades  
Drawing Markups

**NOTE: Drawings reflect conceptual design intent only. Bidders must field verify any information critical to accurate bidding.**

- NOTES:**
1. THIS PLAN IS BASED ON ORIGINAL DRAWINGS PREPARED BY ANDERSON NOTTER FINEGOLD, ARCHITECTS DATED 7-11-79. VARIOUS RENOVATION PROJECT PLANS PROVIDED BY FLETCHER FREE LIBRARY VAULT.
  2. THE BUILDING WAS FIELD CHECKED BY BUXTON DRAFTING SERVICES IN JUNE, 2012. THE PLANS WERE THEN MODIFIED TO REFLECT FIELD MEASUREMENTS. THE ENTIRE BUILDING WAS NOT MEASURED. FOR FUTURE RENOVATIONS, ACTUAL DIMENSIONS MUST BE FIELD VERIFIED.
  3. NO DEMOLITION WAS PERFORMED TO DETERMINE ALL WALL THICKNESSES - WALL THICKNESS MAY VARY FROM LOCATION TO LOCATION. WALL LOCATIONS MUST BE FIELD VERIFIED WHEN NEW RENOVATIONS EMERGE.

USEFUL ATTENTION WAS MADE IN PREPARING THIS PLAN SET TO AVOID CONFLICTS WITH EXISTING CONDITIONS. HOWEVER, THE CONTRACTOR MUST VERIFY ALL CONDITIONS ON SITE. HUMAN ERROR, THE CONTRACTOR MUST VERIFY ALL CONDITIONS ON SITE DURING ANY CONSTRUCTION PHASE.

**CITY OF BURLINGTON  
DEPARTMENT OF PARKS & RECREATION  
BURLINGTON, VERMONT**

(802) 658-0293

**FLETCHER FREE LIBRARY  
BURLINGTON, VERMONT**


**MAIN LEVEL PLAN**

DATE	JUNE 2012
SCALE	1/8" = 1'-0"
DRAWN	LRB
CHECKED	BDS

**A-2**

**LEGEND**

- EXPOSED WOOD BEAM ABOVE
- WOOD BEAM ABOVE
- DR. HEADER TYP. DROPPED DOOR HEADER
- COLUMN
- DOORWAY ARCH, BRICK
- BRICK ARCH

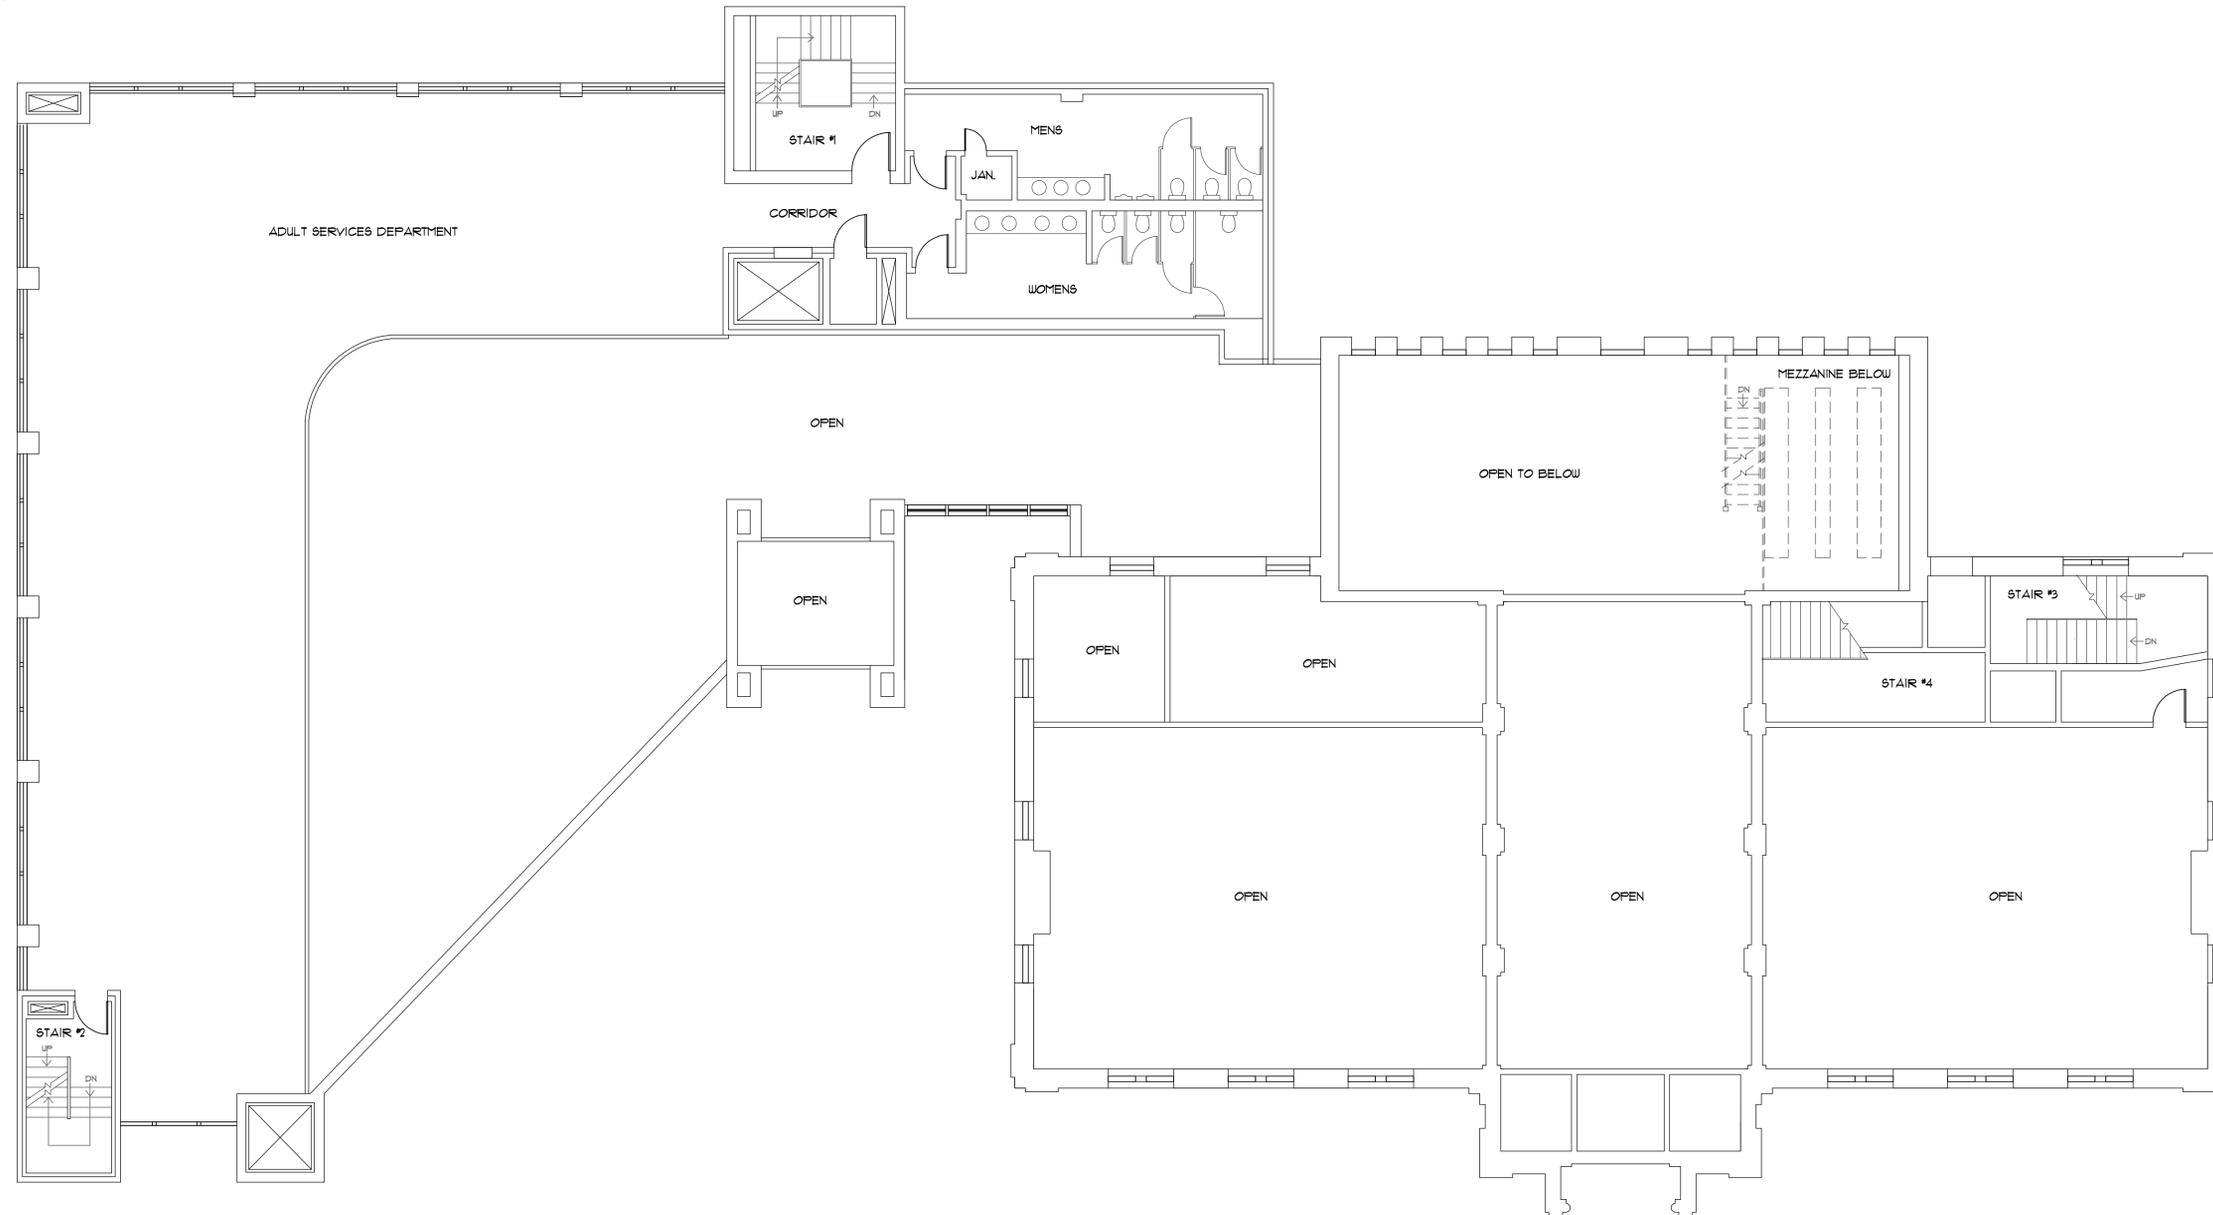

**MEZZANINE LEVEL PLAN**

SCALE: 1/8" = 1'-0"

**Mechanical Demolition Plan  
No demo on this level.**

Cx Associates  
January 30, 2015

City of Burlington FFL HVAC Upgrades  
Drawing Markups

**NOTE: Drawings reflect conceptual design intent only. Bidders must field verify any information critical to accurate bidding.**

**NOTES:**

1. THIS PLAN IS BASED ON ORIGINAL DRAWINGS PREPARED BY ANDERSON NOTTER FINEGOLD, ARCHITECTS DATED 7-11-79. VARIOUS RENOVATION PROJECT PLANS PROVIDED BY FLETCHER FREE LIBRARY VAULT.
2. THE BUILDING WAS FIELD CHECKED BY BUXTON DRAFTING SERVICES IN JUNE, 2012. THE PLANS WERE THEN MODIFIED TO REFLECT FIELD MEASUREMENTS. THE ENTIRE BUILDING WAS NOT MEASURED. FOR FUTURE RENOVATIONS, ACTUAL DIMENSIONS MUST BE FIELD VERIFIED.
3. NO DEMOLITION WAS PERFORMED TO DETERMINE ALL WALL THICKNESSES - WALL THICKNESS MAY VARY FROM LOCATION TO LOCATION. WALL LOCATIONS MUST BE FIELD VERIFIED WHEN NEW RENOVATIONS EMERGE.

USER NOTE: ATTENTION WAS MADE IN PRODUCING THIS PLAN SET TO AVOID HUMAN ERROR. THE CONTRACTOR MUST VERIFY ALL DIMENSIONS AND CONDITIONS DURING ANY CONSTRUCTION PHASE.

**CITY OF BURLINGTON  
DEPARTMENT OF PARKS & RECREATION  
BURLINGTON, VERMONT**

(802) 658-0293

**FLETCHER FREE LIBRARY  
BURLINGTON, VERMONT**


MEZZANINE LEVEL PLAN

DATE	JUNE 2012
SCALE	1/8" = 1'-0"
DRAWN	LRB
CHECKED	BDS

A-4

**LEGEND**

- EXPOSED WOOD BEAM ABOVE
- WOOD BEAM ABOVE
- DR. HEADER TYP. DROPPED DOOR HEADER
- COLUMN
- DOORWAY ARCH, BRICK
- BRICK ARCH

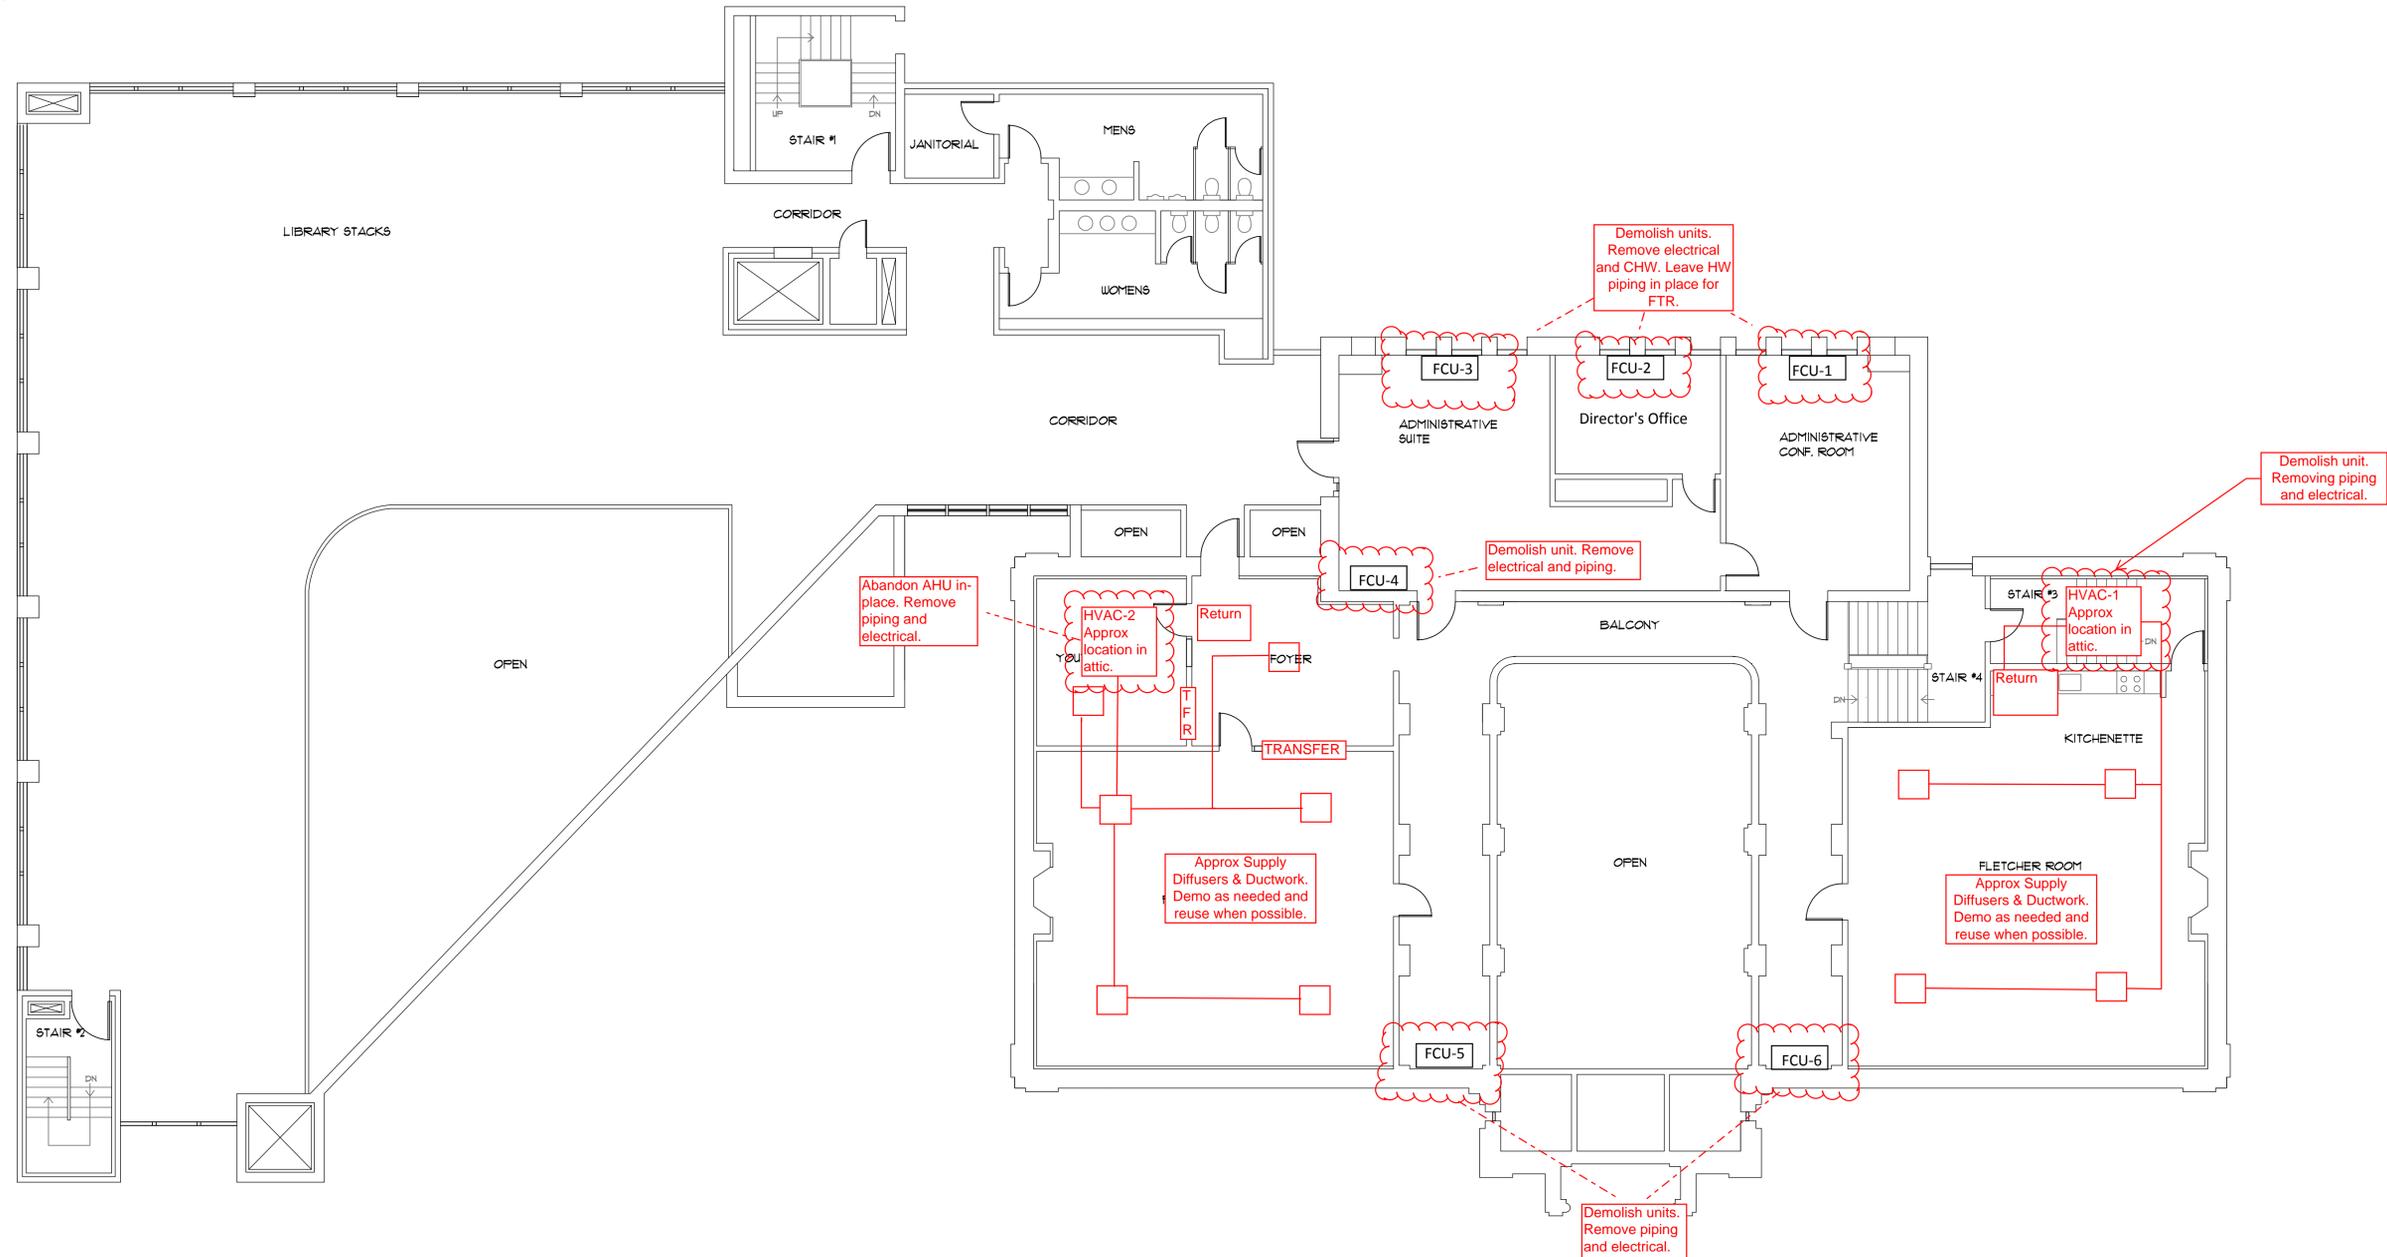

**SECOND LEVEL PLAN**

SCALE: 1/8" = 1'-0"

**Mechanical Demolition Plan**

Cx Associates  
January 30, 2015

City of Burlington FFL HVAC Upgrades  
Drawing Markups

**NOTE:** Drawings reflect conceptual design intent only. Bidders must field verify any information critical to accurate bidding.

**NOTES:**

1. THIS PLAN IS BASED ON ORIGINAL DRAWINGS PREPARED BY ANDERSON NOTTER FINEGOLD, ARCHITECTS DATED 7-11-79. VARIOUS RENOVATION PROJECT PLANS PROVIDED BY FLETCHER FREE LIBRARY VAULT.
2. THE BUILDING WAS FIELD CHECKED BY BUXTON DRAFTING SERVICES IN JUNE, 2012. THE PLANS WERE THEN MODIFIED TO REFLECT FIELD MEASUREMENTS. THE ENTIRE BUILDING WAS NOT MEASURED. FOR FUTURE RENOVATIONS, ACTUAL DIMENSIONS MUST BE FIELD VERIFIED.
3. NO DEMOLITION WAS PERFORMED TO DETERMINE ALL WALL THICKNESSES - WALL THICKNESS MAY VARY FROM LOCATION TO LOCATION. WALL LOCATIONS MUST BE FIELD VERIFIED WHEN NEW RENOVATIONS EMERGE.

USER NOTE: CAREFUL ATTENTION WAS MADE IN PRODUCING THIS PLAN SET TO AVOID ERRORS. HOWEVER, THE CONTRACTOR MUST VERIFY ALL DIMENSIONS AND CONDITIONS ON SITE. THE CONTRACTOR MUST BE RESPONSIBLE FOR ANY ERRORS OR OMISSIONS DURING ANY CONSTRUCTION PHASE.

**CITY OF BURLINGTON  
DEPARTMENT OF PARKS & RECREATION  
BURLINGTON, VERMONT**

(802) 658-0293

**FLETCHER FREE LIBRARY  
BURLINGTON, VERMONT**


SECOND LEVEL PLAN

DATE	JUNE 2012
SCALE	1/8" = 1'-0"
DRAWN	LRB
CHECKED	BDS

**A-3**

**LEGEND**

- EXPOSED WOOD BEAM ABOVE
- WOOD BEAM ABOVE
- DR. HEADER TYP. DROPPED DOOR HEADER
- COLUMN
- DOORWAY ARCH, BRICK
- BRICK ARCH

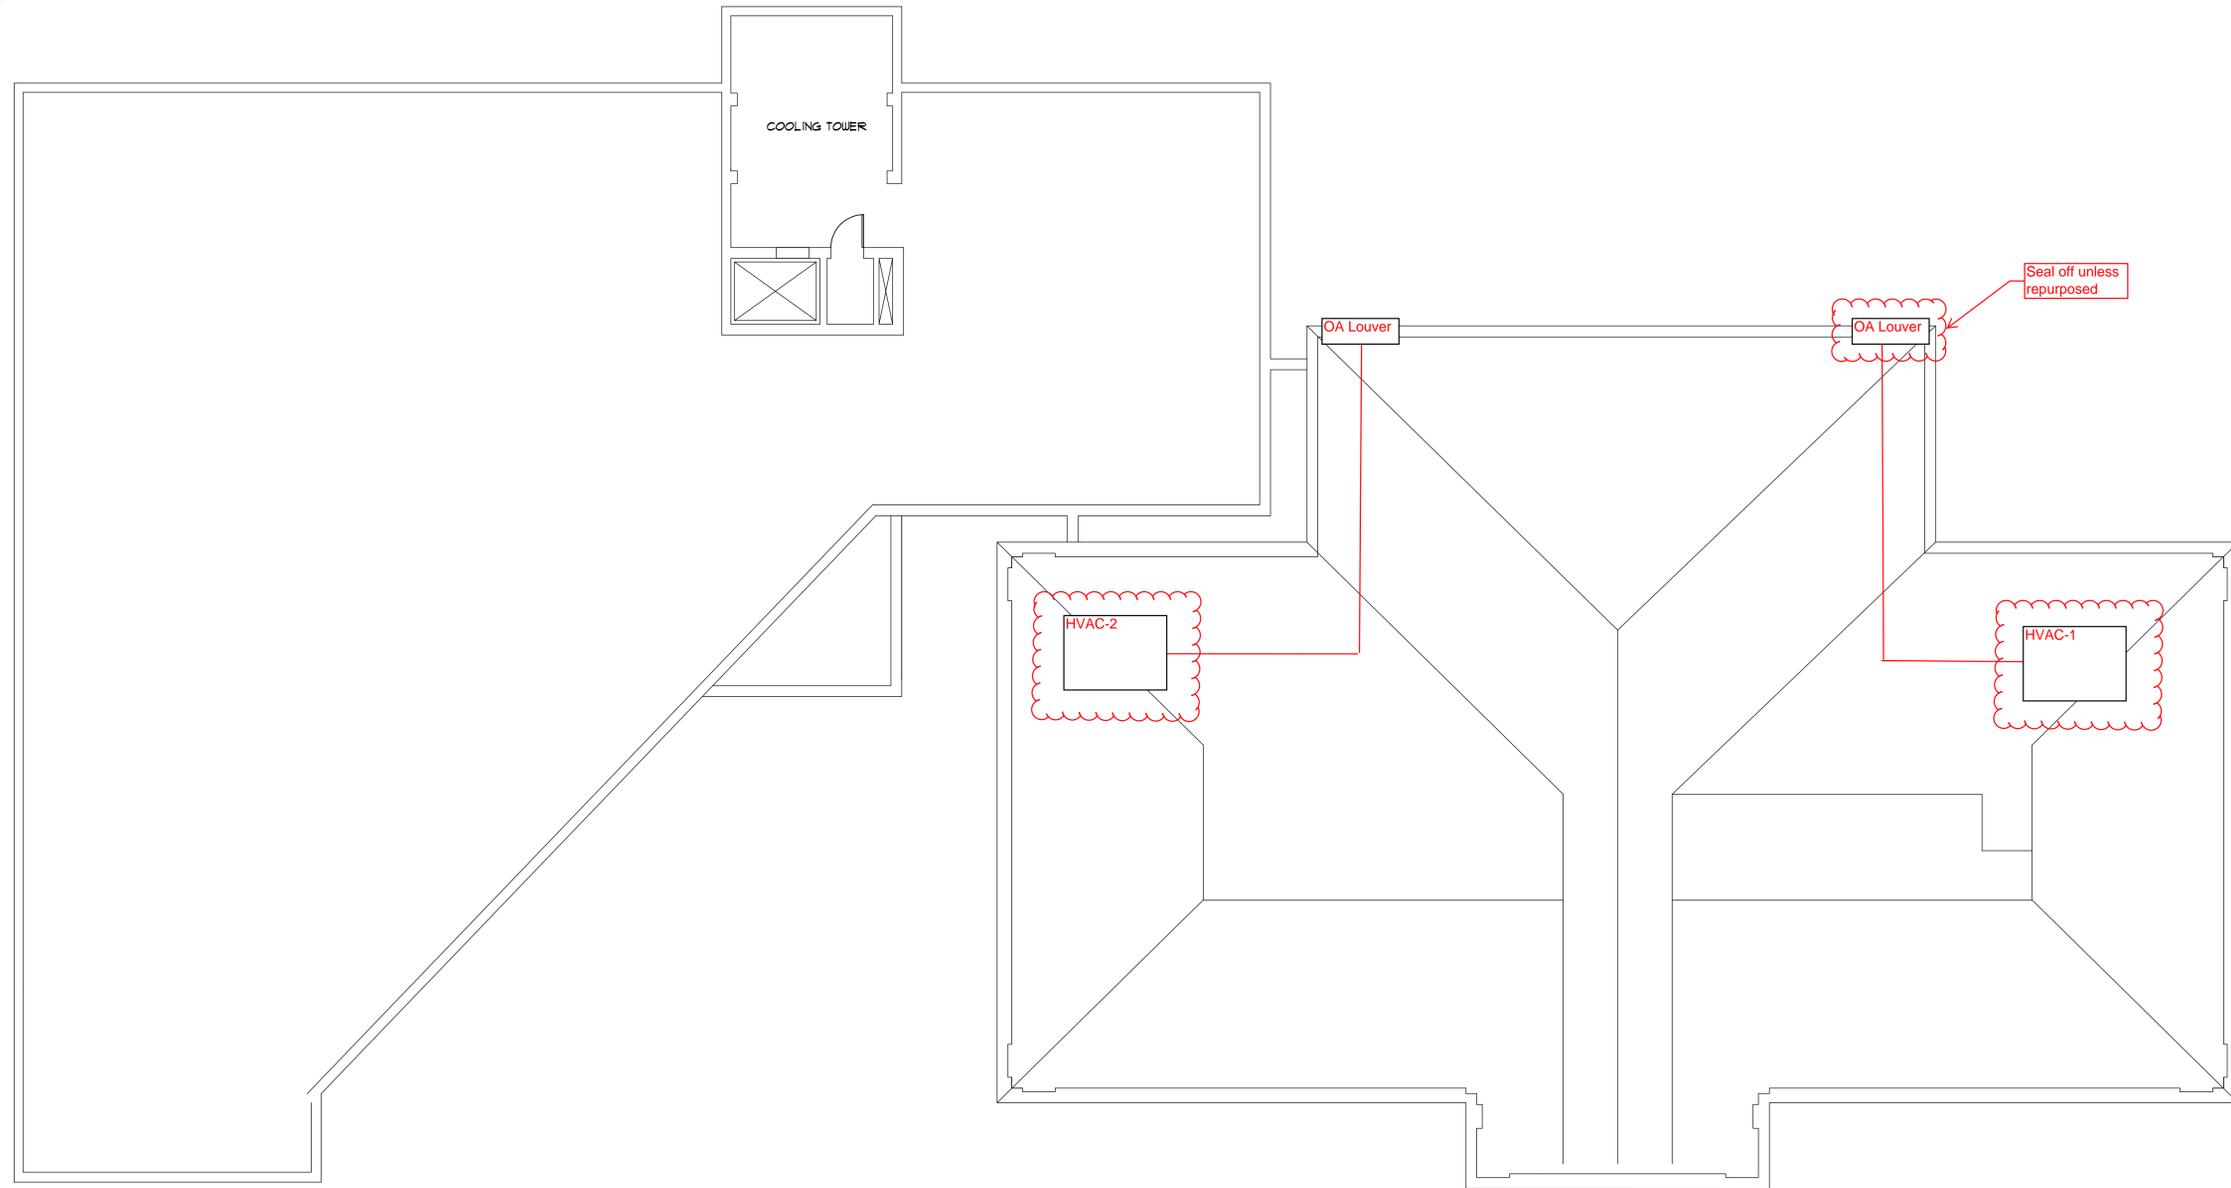

**ROOF LEVEL PLAN**

SCALE: 1/8" = 1'-0"

**Mechanical Demolition Plan**

Cx Associates  
January 30, 2015

City of Burlington FFL HVAC Upgrades  
Drawing Markups

**NOTE: Drawings reflect conceptual design intent only. Bidders must field verify any information critical to accurate bidding.**

**NOTES:**

1. THIS PLAN IS BASED ON ORIGINAL DRAWINGS PREPARED BY ANDERSON NOTTER FINEGOLD, ARCHITECTS DATED 7-11-79. VARIOUS RENOVATION PROJECT PLANS PROVIDED BY FLETCHER FREE LIBRARY VAULT.
2. THE BUILDING WAS FIELD CHECKED BY BUXTON DRAFTING SERVICES IN JUNE, 2012. THE PLANS WERE THEN MODIFIED TO REFLECT FIELD MEASUREMENTS. THE ENTIRE BUILDING WAS NOT MEASURED. FOR FUTURE RENOVATIONS, ACTUAL DIMENSIONS MUST BE FIELD VERIFIED.
3. NO DEMOLITION WAS PERFORMED TO DETERMINE ALL WALL THICKNESSES - WALL THICKNESS MAY VARY FROM LOCATION TO LOCATION. WALL LOCATIONS MUST BE FIELD VERIFIED WHEN NEW RENOVATIONS EMERGE.

USER NOTE:  
 CAREFUL ATTENTION WAS MADE IN  
 PRODUCING THIS PLAN SET TO AVOID  
 ERRORS. HOWEVER, THE CONTRACTOR  
 CANNOT BE HELD RESPONSIBLE FOR  
 HUMAN ERROR. THE CONTRACTOR MUST  
 VERIFY ALL DIMENSIONS AND CONDITIONS  
 DURING ANY CONSTRUCTION PHASE.

**CITY OF BURLINGTON**  
**DEPARTMENT OF PARKS & RECREATION**  
**BURLINGTON, VERMONT**  
**(802) 658-0293**

**FLETCHER FREE LIBRARY**  
**BURLINGTON, VERMONT**


**ROOF LEVEL PLAN**

DATE	JUNE 2012
SCALE	1/8" = 1'-0"
DRAWN	LRB
CHECKED	BDS

A-5

**LEGEND**

- EXPOSED WOOD BEAM ABOVE
- WOOD BEAM ABOVE
- DR. HEADER TYP. DROPPED DOOR HEADER
- COLUMN
- DOORWAY ARCH, BRICK
- BRICK ARCH

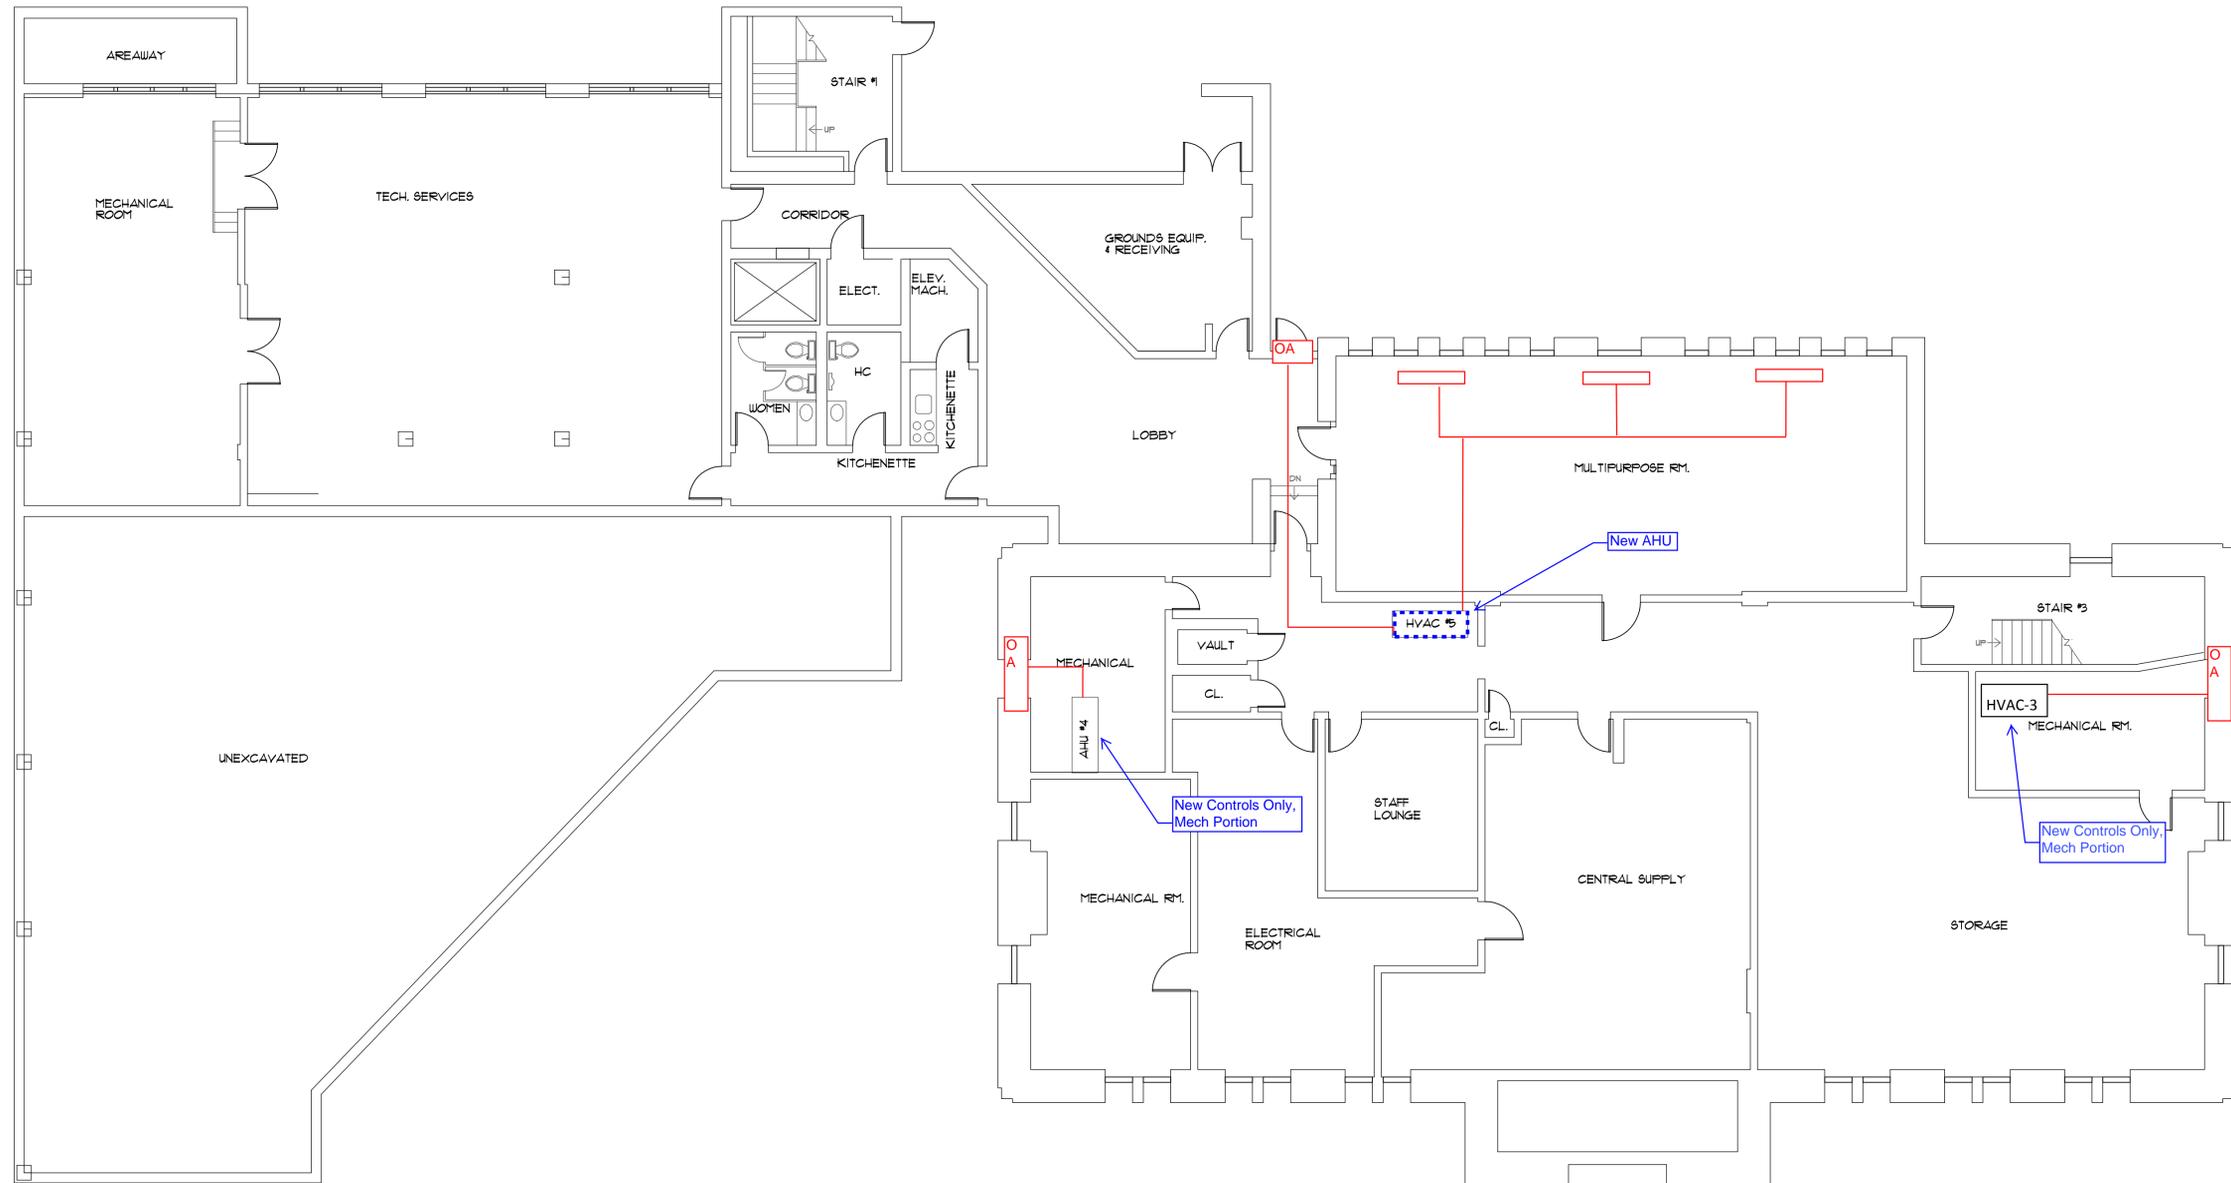

**LOWER LEVEL PLAN**

SCALE: 1/8" = 1'-0"

**New Work Plan**

Cx Associates  
January 30, 2015

City of Burlington FFL HVAC Upgrades  
Drawing Markups

**NOTE: Drawings reflect conceptual design intent only. Bidders must field verify any information critical to accurate bidding.**

**NOTES:**

1. THIS PLAN IS BASED ON ORIGINAL DRAWINGS PREPARED BY ANDERSON NOTTER FINEGOLD, ARCHITECTS DATED 7-11-79. VARIOUS RENOVATION PROJECT PLANS PROVIDED BY FLETCHER FREE LIBRARY VAULT.
2. THE BUILDING WAS FIELD CHECKED BY BUXTON DRAFTING SERVICES IN JUNE, 2012. THE PLANS WERE THEN MODIFIED TO REFLECT FIELD MEASUREMENTS. THE ENTIRE BUILDING WAS NOT MEASURED. FOR FUTURE RENOVATIONS, ACTUAL DIMENSIONS MUST BE FIELD VERIFIED.
3. NO DEMOLITION WAS PERFORMED TO DETERMINE ALL WALL THICKNESSES - WALL THICKNESS MAY VARY FROM LOCATION TO LOCATION. WALL LOCATIONS MUST BE FIELD VERIFIED WHEN NEW RENOVATIONS EMERGE.

USER NOTE: ATTENTION WAS MADE IN PREPARING THIS PLAN SET TO AVOID CONFLICTS WITH EXISTING CONDITIONS. THE CONTRACTOR MUST VERIFY ALL CONDITIONS AND CANNOT BE HELD RESPONSIBLE FOR HUMAN ERROR. THE CONTRACTOR MUST VERIFY ALL CONDITIONS DURING ANY CONSTRUCTION PHASE.

**CITY OF BURLINGTON  
DEPARTMENT OF PARKS & RECREATION  
BURLINGTON, VERMONT**

(802) 658-0293

**FLETCHER FREE LIBRARY  
BURLINGTON, VERMONT**


**LOWER LEVEL PLAN**

DATE	JUNE 2012
SCALE	1/8" = 1'-0"
DRAWN	LRB
CHECKED	BDS

A-1

**LEGEND**

- EXPOSED WOOD BEAM ABOVE
- WOOD BEAM ABOVE
- DR. HEADER TYP. DROPPED DOOR HEADER
- COLUMN
- DOORWAY ARCH, BRICK
- BRICK ARCH

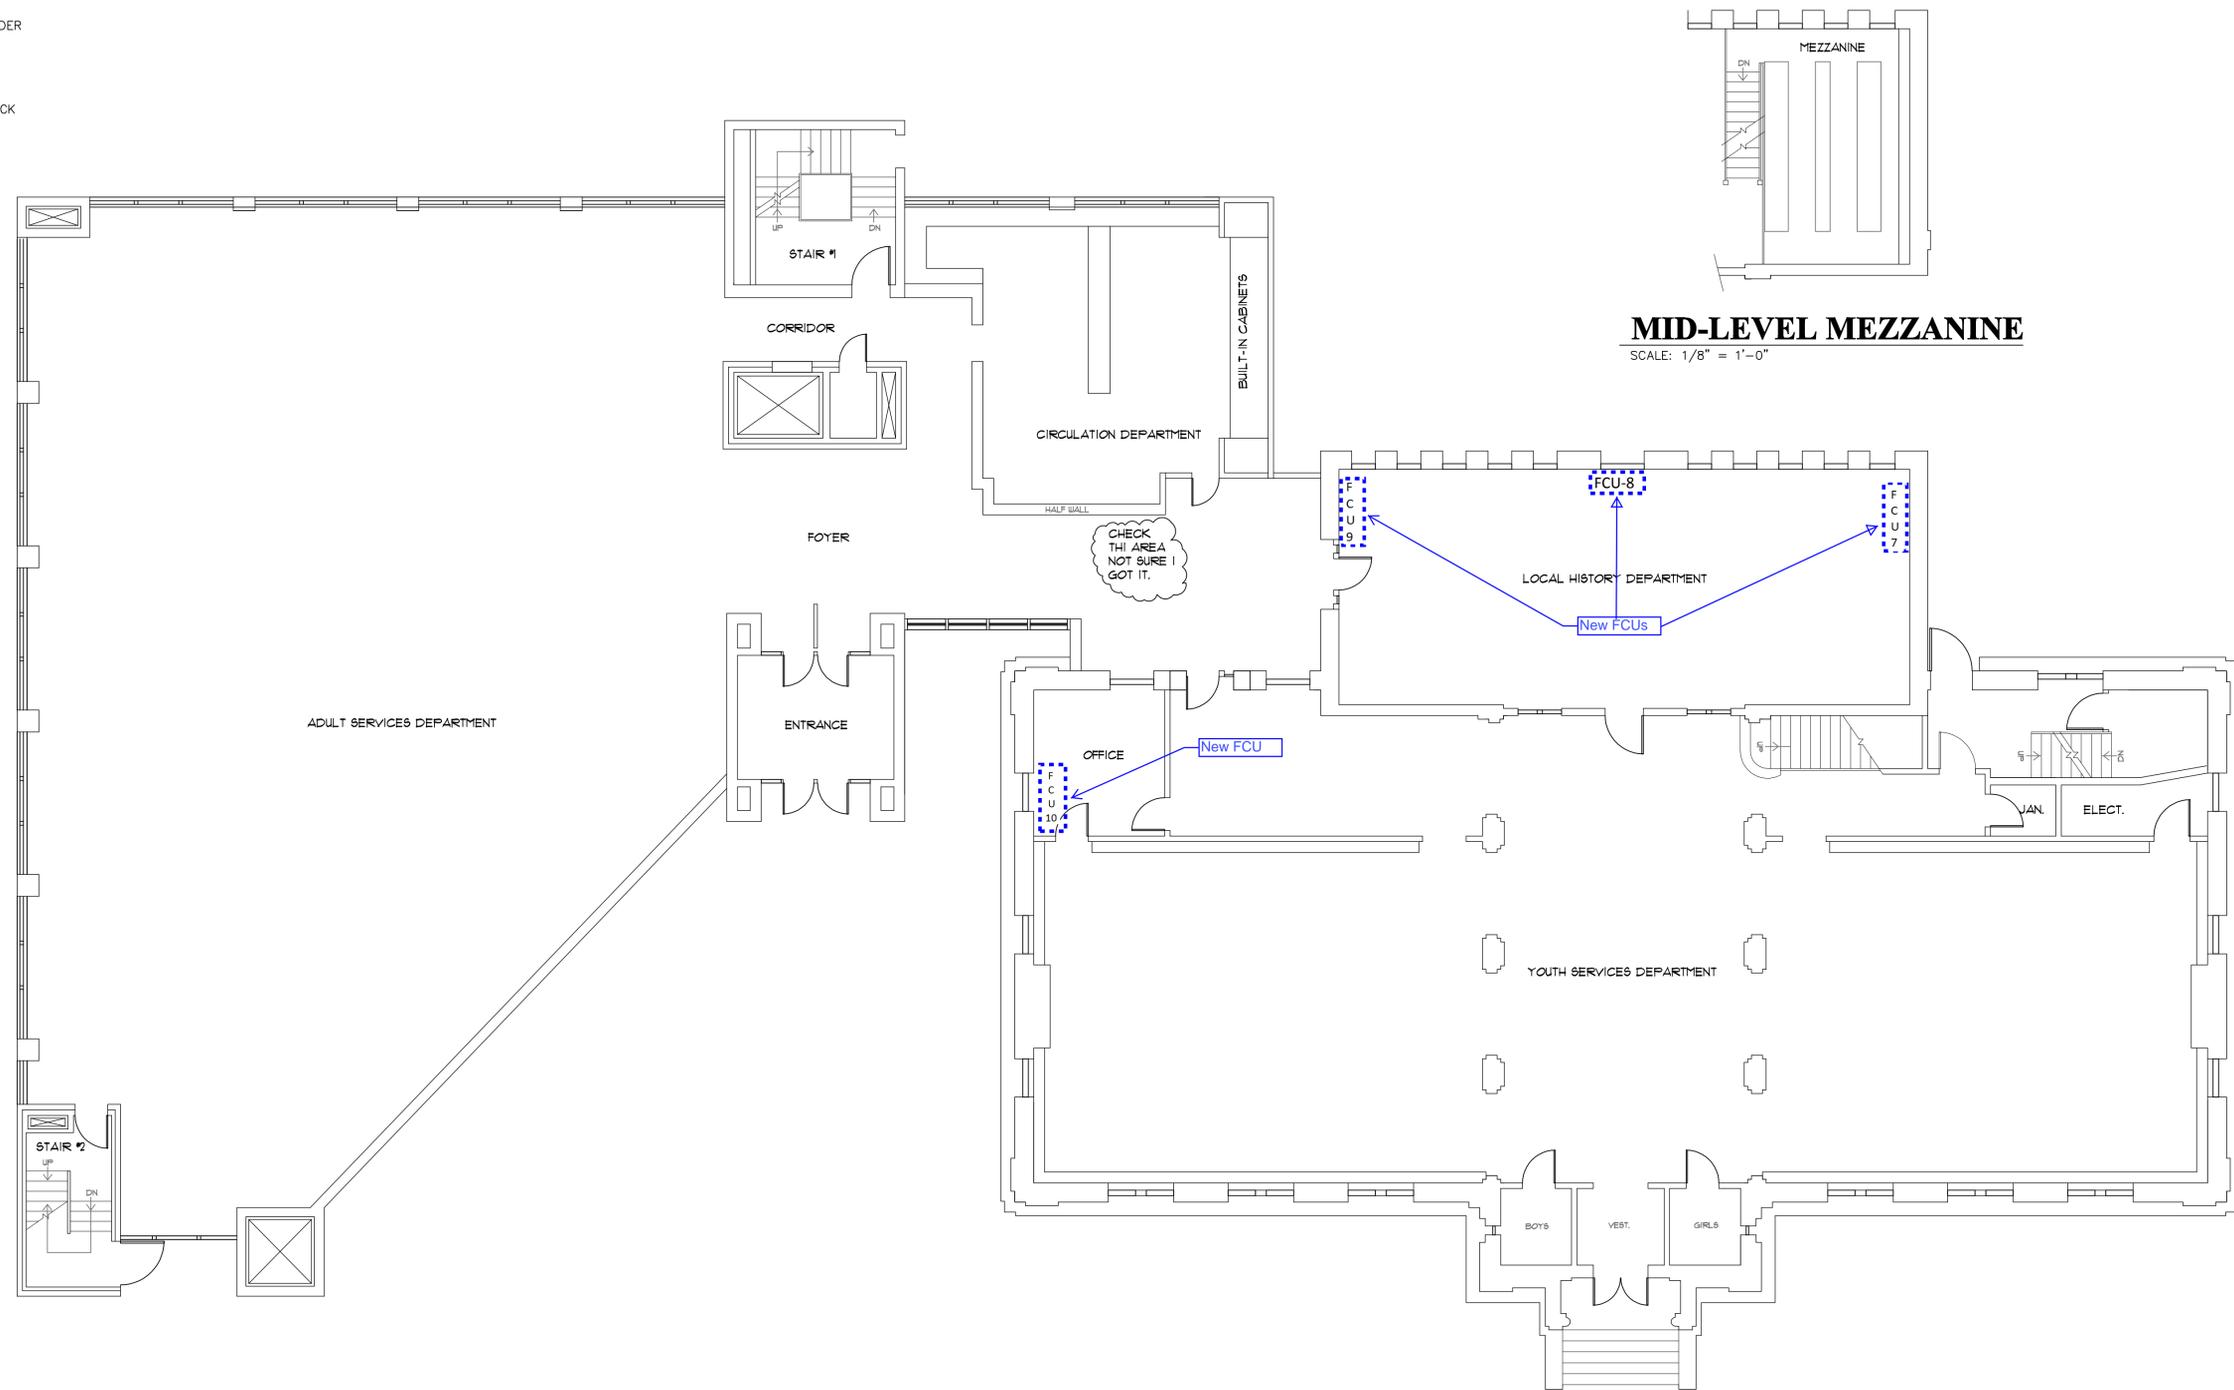

**MAIN LEVEL PLAN**

SCALE: 1/8" = 1'-0"

**New Work Plan**

Cx Associates  
January 30, 2015

City of Burlington FFL HVAC Upgrades  
Drawing Markups

**NOTE: Drawings reflect conceptual design intent only. Bidders must field verify any information critical to accurate bidding.**

**NOTES:**

1. THIS PLAN IS BASED ON ORIGINAL DRAWINGS PREPARED BY ANDERSON NOTTER FINEGOLD, ARCHITECTS DATED 7-11-79. VARIOUS RENOVATION PROJECT PLANS PROVIDED BY FLETCHER FREE LIBRARY VAULT.
2. THE BUILDING WAS FIELD CHECKED BY BUXTON DRAFTING SERVICES IN JUNE, 2012. THE PLANS WERE THEN MODIFIED TO REFLECT FIELD MEASUREMENTS. THE ENTIRE BUILDING WAS NOT MEASURED. FOR FUTURE RENOVATIONS, ACTUAL DIMENSIONS MUST BE FIELD VERIFIED.
3. NO DEMOLITION WAS PERFORMED TO DETERMINE ALL WALL THICKNESSES - WALL THICKNESS MAY VARY FROM LOCATION TO LOCATION. WALL LOCATIONS MUST BE FIELD VERIFIED WHEN NEW RENOVATIONS EMERGE.

USER NOTE: ATTENTION WAS MADE IN PRODUCING THIS PLAN SET TO AVOID HUMAN ERROR. THE CONTRACTOR MUST VERIFY ALL DIMENSIONS AND CONDITIONS DURING ANY CONSTRUCTION PHASE.

**CITY OF BURLINGTON  
DEPARTMENT OF PARKS & RECREATION  
BURLINGTON, VERMONT**

(802) 658-0293

**FLETCHER FREE LIBRARY  
BURLINGTON, VERMONT**


MAIN LEVEL PLAN

DATE	JUNE 2012
SCALE	1/8" = 1'-0"
DRAWN	LRB
CHECKED	BDS

**A-2**

**LEGEND**

- EXPOSED WOOD BEAM ABOVE
- WOOD BEAM ABOVE
- DR. HEADER TYP. DROPPED DOOR HEADER
- COLUMN
- DOORWAY ARCH, BRICK
- BRICK ARCH

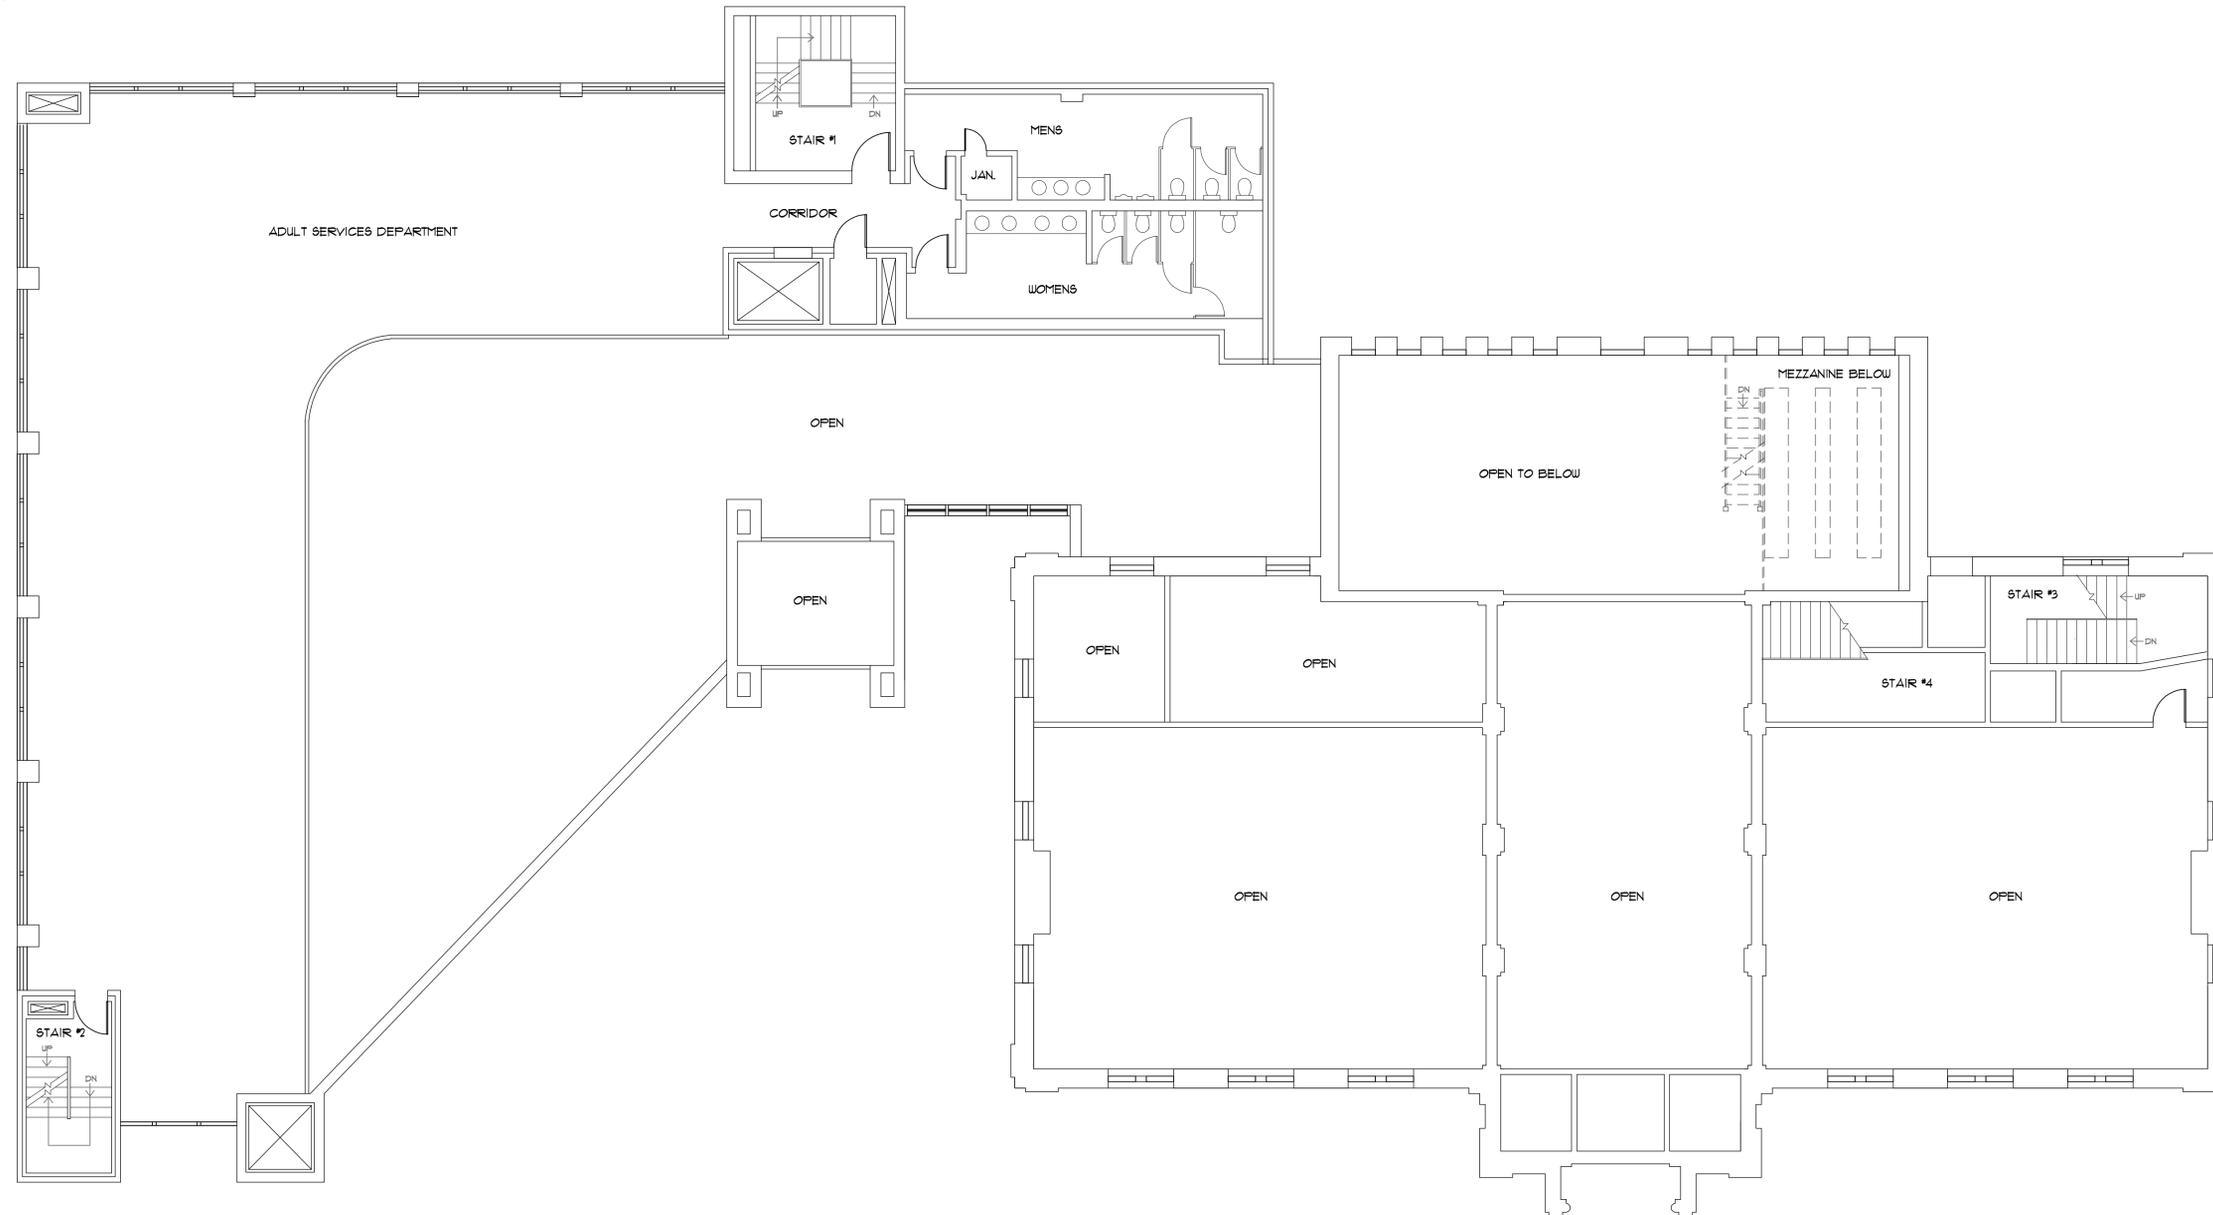

**MEZZANINE LEVEL PLAN**

SCALE: 1/8" = 1'-0"

**No New Work on Mezzanine**

Cx Associates  
January 30, 2015

City of Burlington FFL HVAC Upgrades  
Drawing Markups

**NOTE: Drawings reflect conceptual design intent only. Bidders must field verify any information critical to accurate bidding.**

**NOTES:**

1. THIS PLAN IS BASED ON ORIGINAL DRAWINGS PREPARED BY ANDERSON NOTTER FINEGOLD, ARCHITECTS DATED 7-11-79. VARIOUS RENOVATION PROJECT PLANS PROVIDED BY FLETCHER FREE LIBRARY VAULT.
2. THE BUILDING WAS FIELD CHECKED BY BUXTON DRAFTING SERVICES IN JUNE, 2012. THE PLANS WERE THEN MODIFIED TO REFLECT FIELD MEASUREMENTS. THE ENTIRE BUILDING WAS NOT MEASURED. FOR FUTURE RENOVATIONS, ACTUAL DIMENSIONS MUST BE FIELD VERIFIED.
3. NO DEMOLITION WAS PERFORMED TO DETERMINE ALL WALL THICKNESSES - WALL THICKNESS MAY VARY FROM LOCATION TO LOCATION. WALL LOCATIONS MUST BE FIELD VERIFIED WHEN NEW RENOVATIONS EMERGE.

USER NOTE: ATTENTION WAS MADE IN PREPARING THIS PLAN SET TO AVOID CONFLICTS WITH EXISTING CONDITIONS. HOWEVER, THE CONTRACTOR MUST VERIFY ALL CONDITIONS ON SITE. HUMAN ERROR, THE CONTRACTOR MUST BE RESPONSIBLE FOR ANY ERRORS DURING ANY CONSTRUCTION PHASE.

**CITY OF BURLINGTON  
DEPARTMENT OF PARKS & RECREATION  
BURLINGTON, VERMONT**

(802) 658-0293

**FLETCHER FREE LIBRARY  
BURLINGTON, VERMONT**


MEZZANINE LEVEL PLAN

DATE	JUNE 2012
SCALE	1/8" = 1'-0"
DRAWN	LRB
CHECKED	BDS

A-4

**LEGEND**

- EXPOSED WOOD BEAM ABOVE
- WOOD BEAM ABOVE
- DR. HEADER TYP. DROPPED DOOR HEADER
- COLUMN
- DOORWAY ARCH, BRICK
- BRICK ARCH

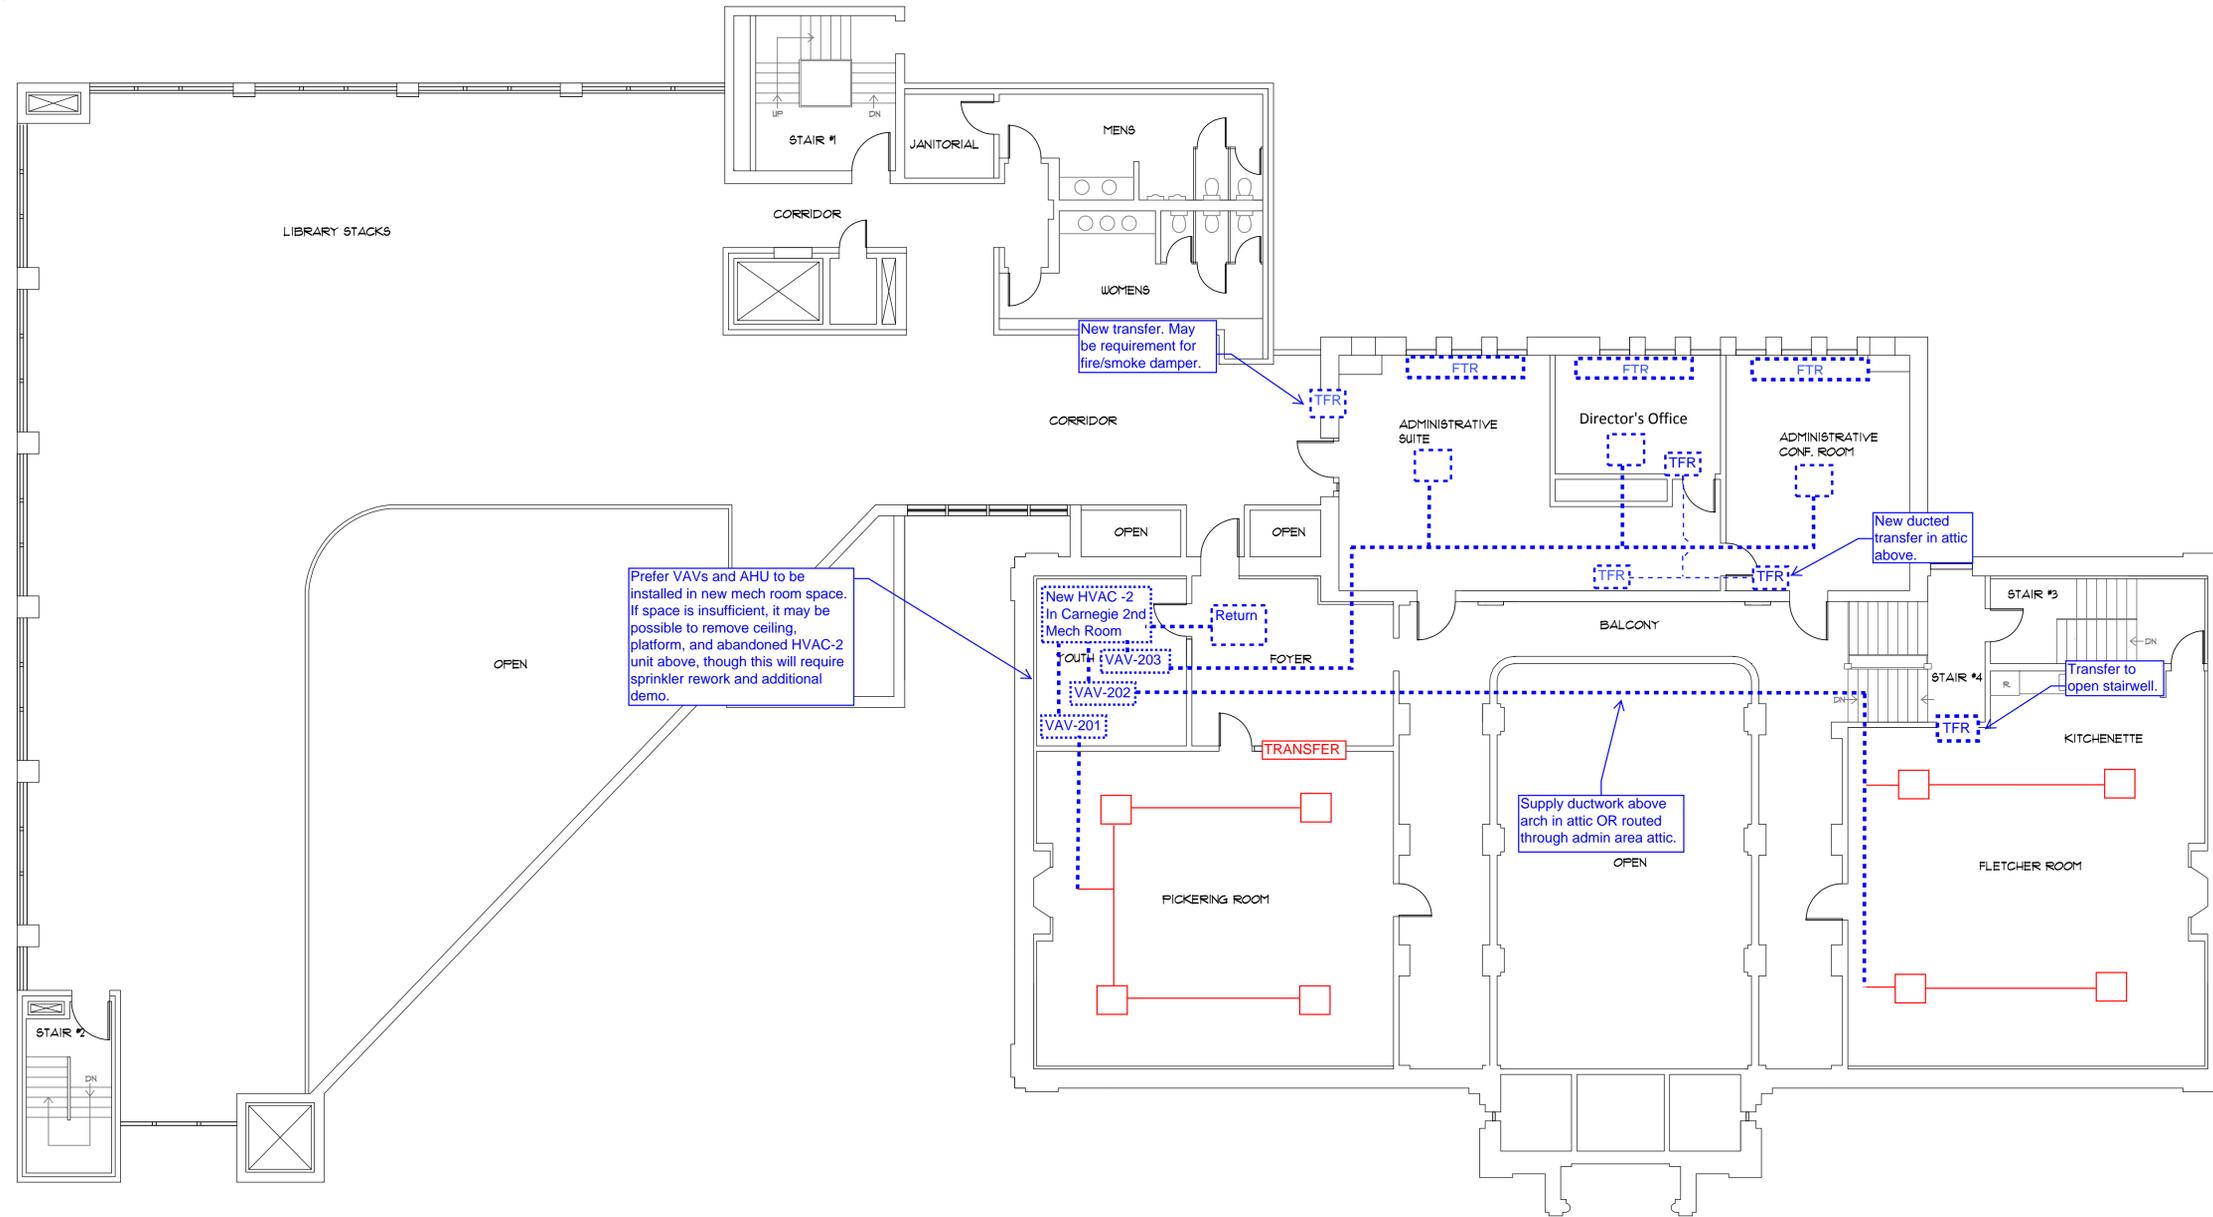

**SECOND LEVEL PLAN**

SCALE: 1/8" = 1'-0"

**New Work Plan**

Cx Associates  
January 30, 2015

City of Burlington FFL HVAC Upgrades  
Drawing Markups

**NOTE: Drawings reflect conceptual design intent only. Bidders must field verify any information critical to accurate bidding.**

**NOTES:**

1. THIS PLAN IS BASED ON ORIGINAL DRAWINGS PREPARED BY ANDERSON NOTTER FINEGOLD, ARCHITECTS DATED 7-11-79. VARIOUS RENOVATION PROJECT PLANS PROVIDED BY FLETCHER FREE LIBRARY VAULT.
2. THE BUILDING WAS FIELD CHECKED BY BUXTON DRAFTING SERVICES IN JUNE, 2012. THE PLANS WERE THEN MODIFIED TO REFLECT FIELD MEASUREMENTS. THE ENTIRE BUILDING WAS NOT MEASURED. FOR FUTURE RENOVATIONS, ACTUAL DIMENSIONS MUST BE FIELD VERIFIED.
3. NO DEMOLITION WAS PERFORMED TO DETERMINE ALL WALL THICKNESSES - WALL THICKNESS MAY VARY FROM LOCATION TO LOCATION. WALL LOCATIONS MUST BE FIELD VERIFIED WHEN NEW RENOVATIONS EMERGE.

USER NOTE: ATTENTION WAS MADE IN PREPARING THIS PLAN SET TO AVOID CONFLICTS WITH EXISTING CONDITIONS. HOWEVER, THE CONTRACTOR MUST VERIFY ALL CONDITIONS DURING ANY CONSTRUCTION PHASE.

**CITY OF BURLINGTON  
DEPARTMENT OF PARKS & RECREATION  
BURLINGTON, VERMONT**

(802) 658-0293

**FLETCHER FREE LIBRARY  
BURLINGTON, VERMONT**


**SECOND LEVEL PLAN**

DATE	JUNE 2012
SCALE	1/8" = 1'-0"
DRAWN	LRB
CHECKED	BDS

**A-3**

**LEGEND**

- EXPOSED WOOD BEAM ABOVE
- WOOD BEAM ABOVE
- DR. HEADER TYP. DROPPED DOOR HEADER
- COLUMN
- DOORWAY ARCH, BRICK
- BRICK ARCH

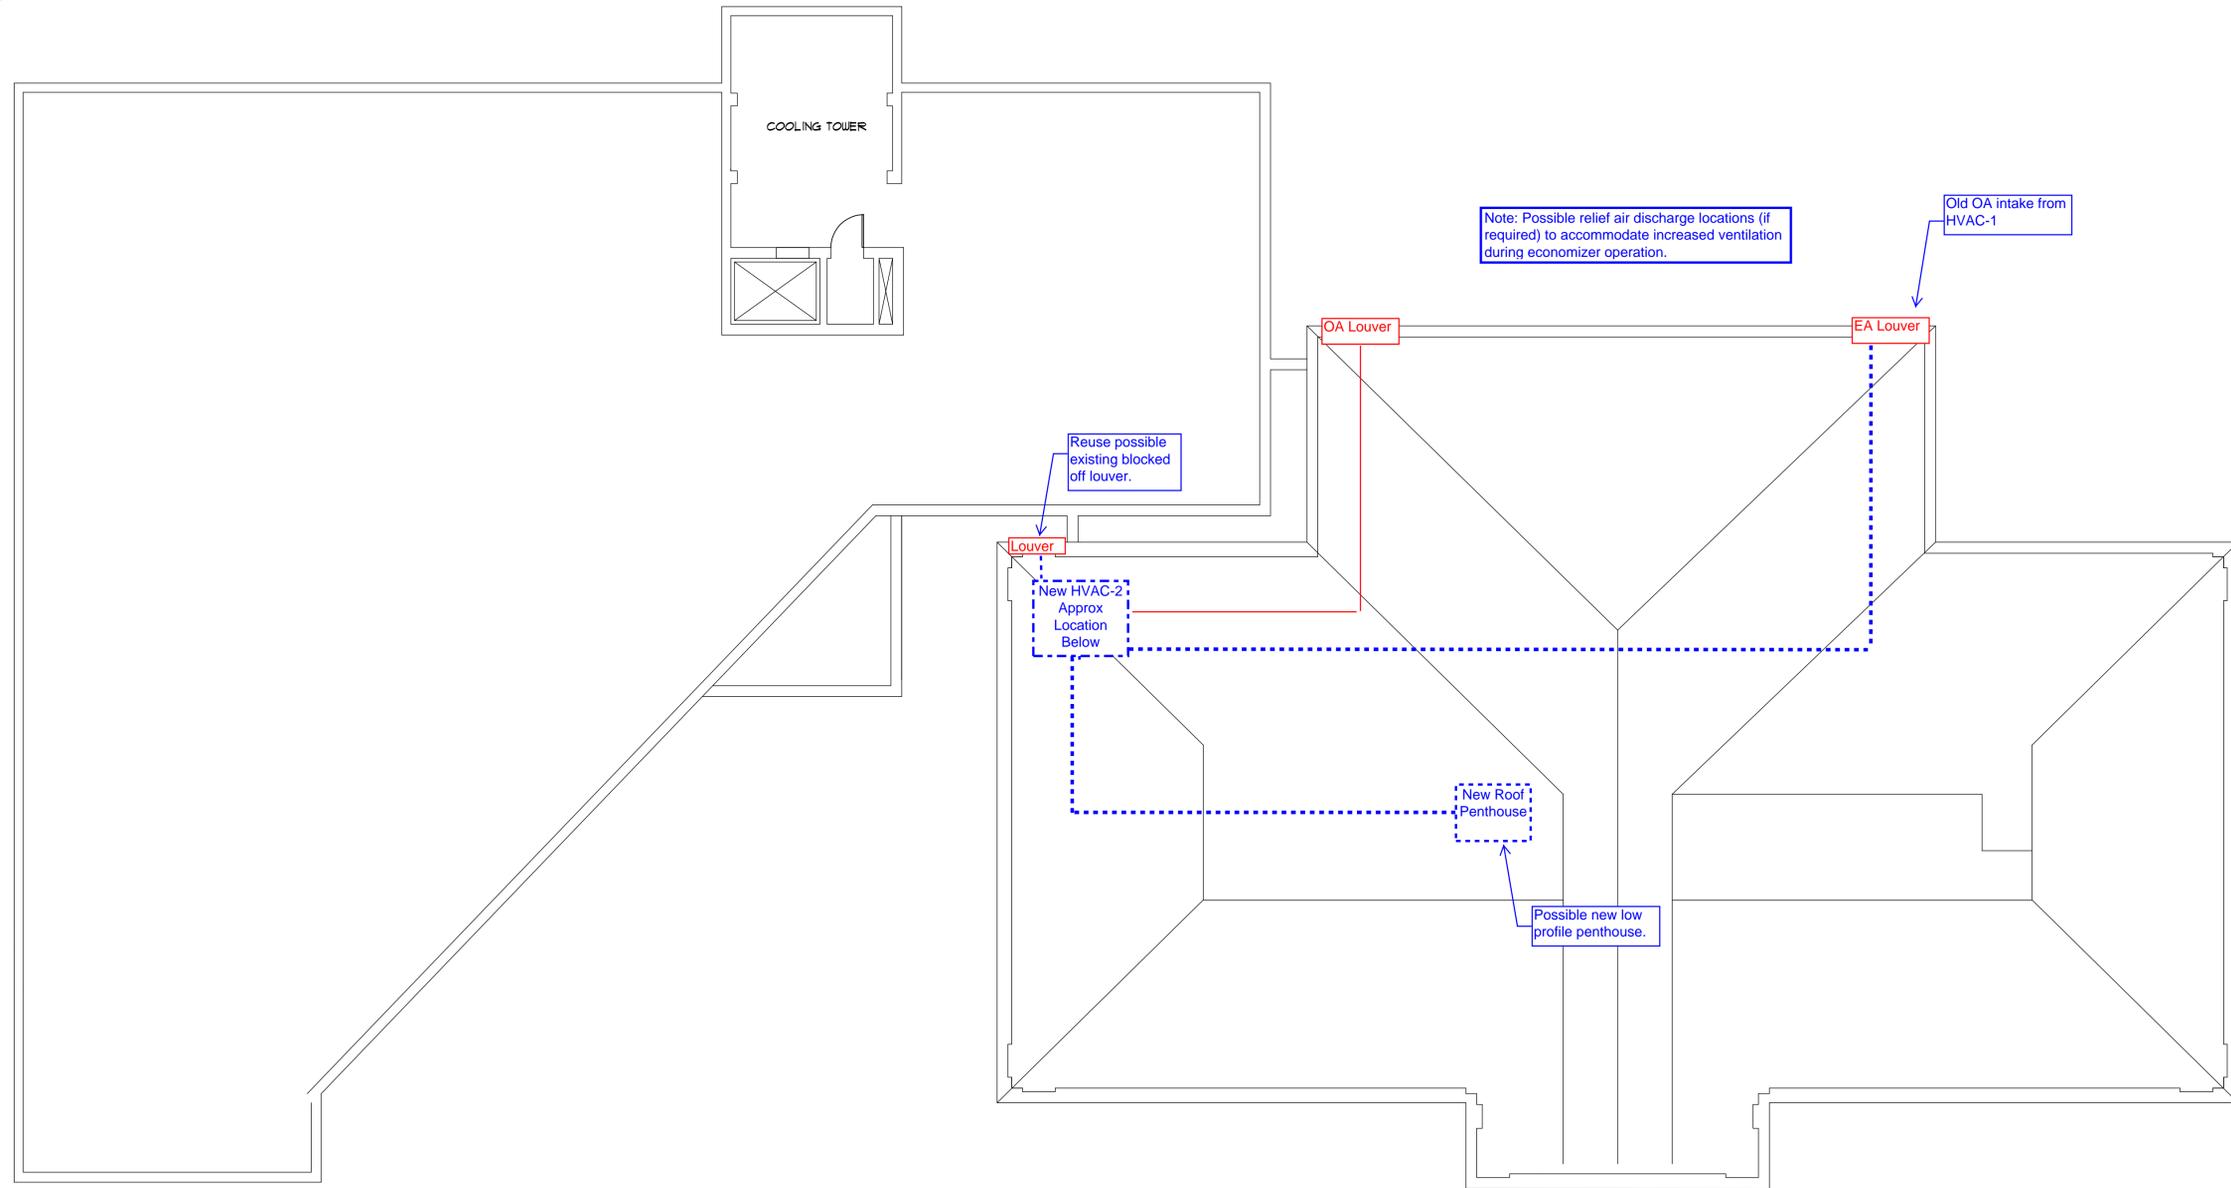

**ROOF LEVEL PLAN**

SCALE: 1/8" = 1'-0"

**New Work Plan**

Cx Associates  
January 30, 2015

City of Burlington FFL HVAC Upgrades  
Drawing Markups

**NOTE: Drawings reflect conceptual design intent only. Bidders must field verify any information critical to accurate bidding.**

**NOTES:**

1. THIS PLAN IS BASED ON ORIGINAL DRAWINGS PREPARED BY ANDERSON NOTTER FINEGOLD, ARCHITECTS DATED 7-11-79. VARIOUS RENOVATION PROJECT PLANS PROVIDED BY FLETCHER FREE LIBRARY VAULT.
2. THE BUILDING WAS FIELD CHECKED BY BUXTON DRAFTING SERVICES IN JUNE, 2012. THE PLANS WERE THEN MODIFIED TO REFLECT FIELD MEASUREMENTS. THE ENTIRE BUILDING WAS NOT MEASURED. FOR FUTURE RENOVATIONS, ACTUAL DIMENSIONS MUST BE FIELD VERIFIED.
3. NO DEMOLITION WAS PERFORMED TO DETERMINE ALL WALL THICKNESSES - WALL THICKNESS MAY VARY FROM LOCATION TO LOCATION. WALL LOCATIONS MUST BE FIELD VERIFIED WHEN NEW RENOVATIONS EMERGE.

USER NOTE:  
 CAREFUL ATTENTION WAS MADE IN PREPARING THIS PLAN SET TO AVOID CONFLICTS WITH EXISTING CONDITIONS. HOWEVER, THE CONTRACTOR MUST VERIFY ALL CONDITIONS ON SITE. HUMAN ERROR, THE CONTRACTOR MUST VERIFY ALL CONDITIONS ON SITE DURING ANY CONSTRUCTION PHASES.

**CITY OF BURLINGTON**  
**DEPARTMENT OF PARKS & RECREATION**  
**BURLINGTON, VERMONT**

(802) 658-0293

**FLETCHER FREE LIBRARY**  
**BURLINGTON, VERMONT**

ROOF LEVEL PLAN

DATE	JUNE 2012
SCALE	1/8" = 1'-0"
DRAWN	LRB
CHECKED	BDS

A-5